IREDELL COUNTY HEALTH DEPARTMENT

STATESVILLE 704-878-5305 MOORESVILLE 704-664-5281

IMPROVEMENT PERMIT / CERTIFICATE OF COMPLETION / OPERATION PERMIT / EXISTING SYSTEM INSPECTION

PROPERTY DESCRIPTION NO. 14158 DATE July 12, '94 TAX MAP NO. 2A6A 16 / 4645-33-0162 Watershed: ☑ Yes ☐ No LR

OWNER OR CONTRACTOR Robert E. Jacks Jr. PHONE: Business 581-5604 Home

ADDRESS PO Box 5000-269 / Mooresville

LOCATION 115 S. TR Langtree TR Carson's Place on Right

SUBDIVISION Carson's Place BLOCK / SECTION LOT 22 LOT AREA 110'X295' SITE CLASS. PS per 1996 DESIGN FLOW 360gpd L.T.A.R. .3

Septic Tank: 1000 Gallons; STB 714 Hellings Date 11-12-94

Pump Tank: Gallons; PT Date

Pump Make: Model Serial No.

Nitrification Field: No. Fields 1 Square Feet Linear Feet 200

No Lines 3-4 Trench Width 24" Max Trench Bottom Depth 36" Gravel Depth NA

☑ New System ☐ Repair System Type: I, II, III, IV, V, VI

System Description: gravity PVCPS

Repair System Description: same

Maintenance Agreement Required: ☐ Yes ☐ No

☑ House/Mod. Home No. Bedrooms 3

☐ Mobile Home No. Bathrooms 2½

☐ Business No. Employees

☐ Other

☐ Slab ☑ Crawl Space ☐ Basement w/plumbing ☐ Basement wo/plumbing


Water Supply: ☑ Individual ☐ Community ☐ Public

Comments: Plumbing must exit house at grade to accomodate specified max trench bottom depth.


10/27/94 OK to exit plumbing at grade where x

Comments:

INITIAL SITE SKETCH

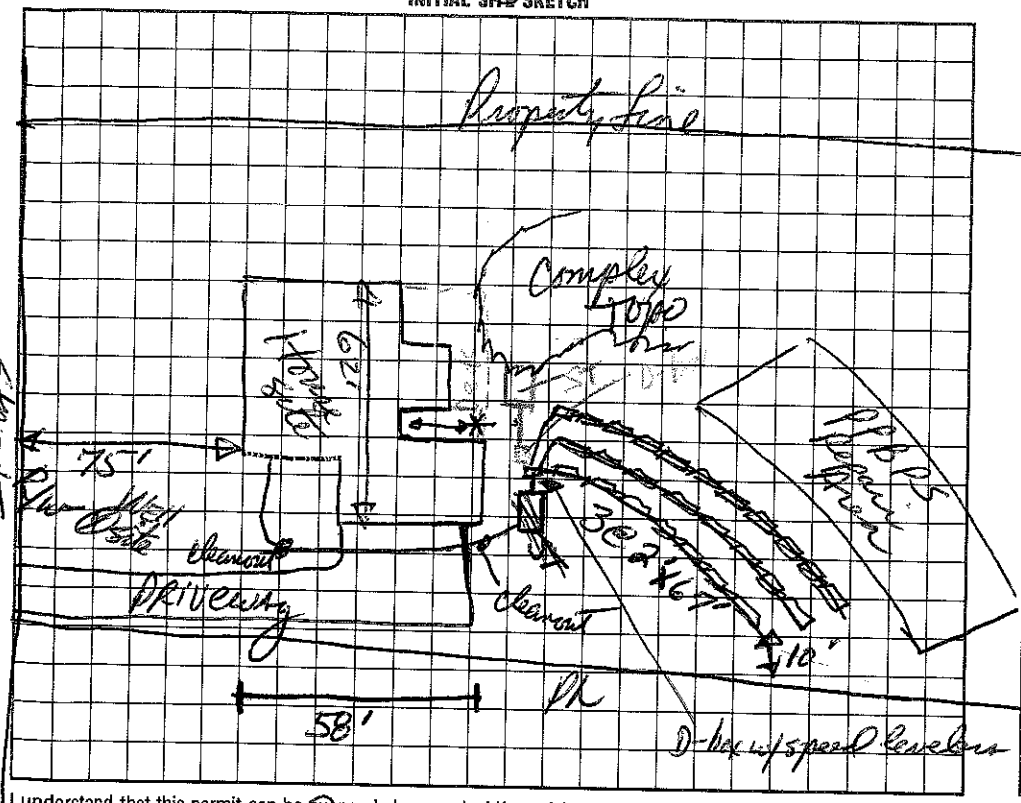

AS BUILT SKETCH

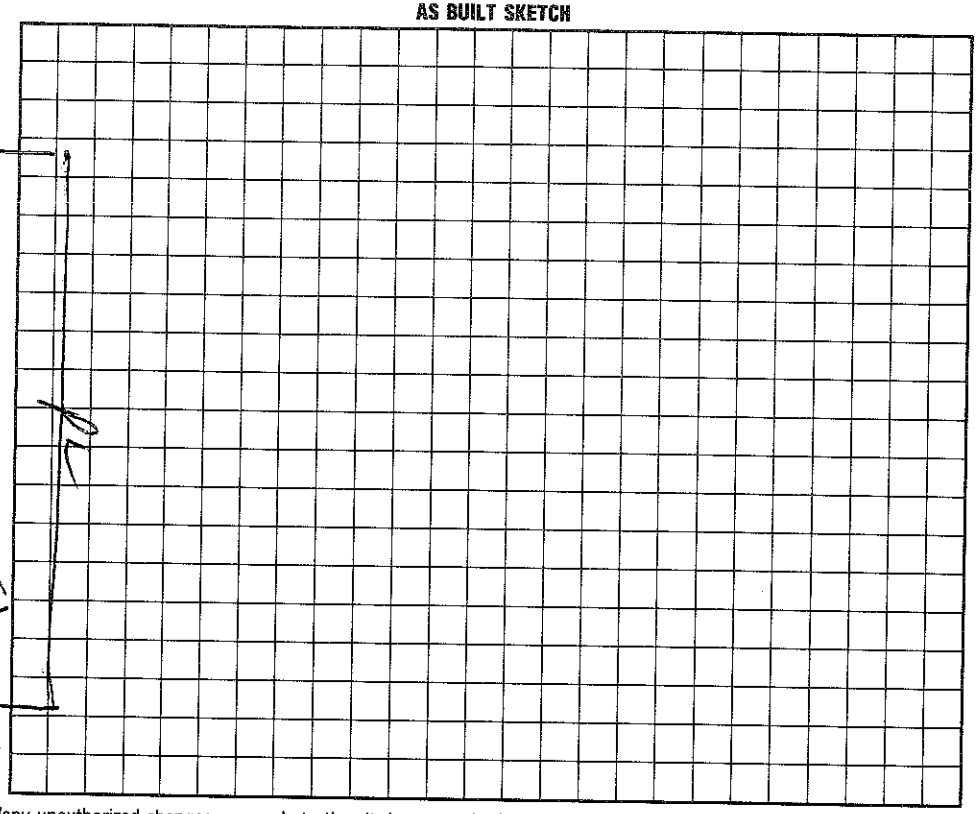

I understand that this permit can be suspended or revoked if any false information is supplied toward securing the permit/any unauthorized changes are made to the site/any unauthorized changes are made in the installation of the system. Improvement Permit is valid for 60 months from date of issuance.

Signed: Robert E Jacks

Improvement Permit by: David R. Hyman, REHS date 7/12/94

Existing System Inspection by: date

Installed by:

Certificate of Completion by: date

Operation Permit by: date 2-6-95

HEALTH DEPT. COPY: WHITE INSPECTION COPY (FINAL): GREEN OWNER COPY (FINAL): YELLOW INSPECTION COPY (INITIAL): PINK OWNER COPY (INITIAL): GOLD