IREDELL COUNTY HEALTH DEPARTMENT

STATESVILLE 704-878-5305 MOORESVILLE 704-664-5281

IMPROVEMENT PERMIT / CERTIFICATE OF COMPLETION / OPERATION PERMIT / EXISTING SYSTEM INSPECTION

PROPERTY DESCRIPTION NO. 18206 DATE Aug 1 '94 TAX MAP NO. 2A6A17 | 4445-33-0214 Watershed: ☑ Yes ☐ No

OWNER OR CONTRACTOR ~~H.H. Contractors~~ / Robert Abernethy PHONE: Business 892 9106 Home

ADDRESS ~~Kz Custom Homes~~

LOCATION 1155 TR Langtree TR Carson's Place ~1300' on Rt

SUBDIVISION Carson's Place BLOCK / SECTION ____ LOT 2 LOT AREA 20,000 ~~ft²~~ ± SITE CLASS. PS per 1996 DESIGN FLOW 240 gpd L.T.A.R. .25-.3

Septic Tank: 1000 Gallons; STB H+H Mellenger Date 10/21/94

Pump Tank: ____ Gallons; PT ____ Date ____

Pump Make: ____ Model ____ Serial No. ____

Nitrification Field: No Fields 1 Square Feet ____ Linear Feet 160

No Lines 4 Trench Width 24" Max Trench Bottom Depth 30" Gravel Depth NA

☑ New System ☐ Repair System Type: I, II, III, IV, V, VI

System Description: gravity PPBRS

Repair System Description: ~~same~~

Maintenance Agreement Required: ☐ Yes ☑ No

☑ House/Mod. Home No. Bedrooms 2

☐ Mobile Home No. Bathrooms 2½

☐ Business No. Employees ____

☐ Other ____


☐ Slab ☑ Crawl Space ☐ Basement w/plumbing ☐ Basement wo/plumbing

Water Supply: ☑ Individual ☐ Community ☐ Public


Comments: follow contours w/ laterals

Comments: Installed substantially as shown.

INITIAL SITE SKETCH

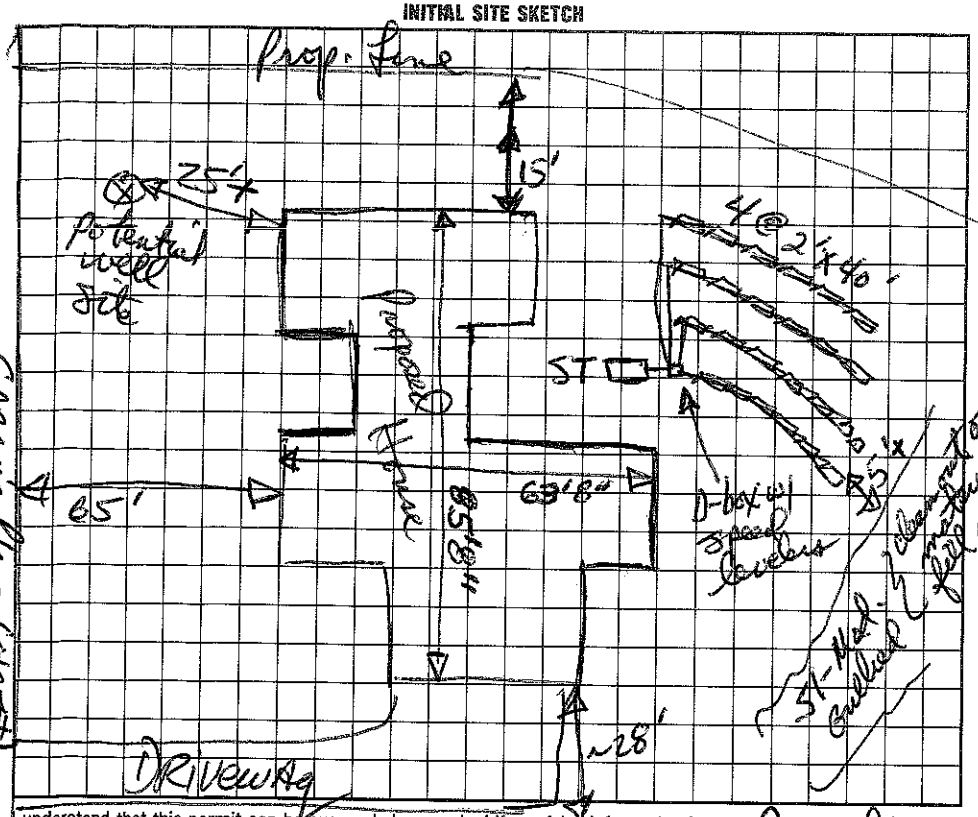

AS BUILT SKETCH

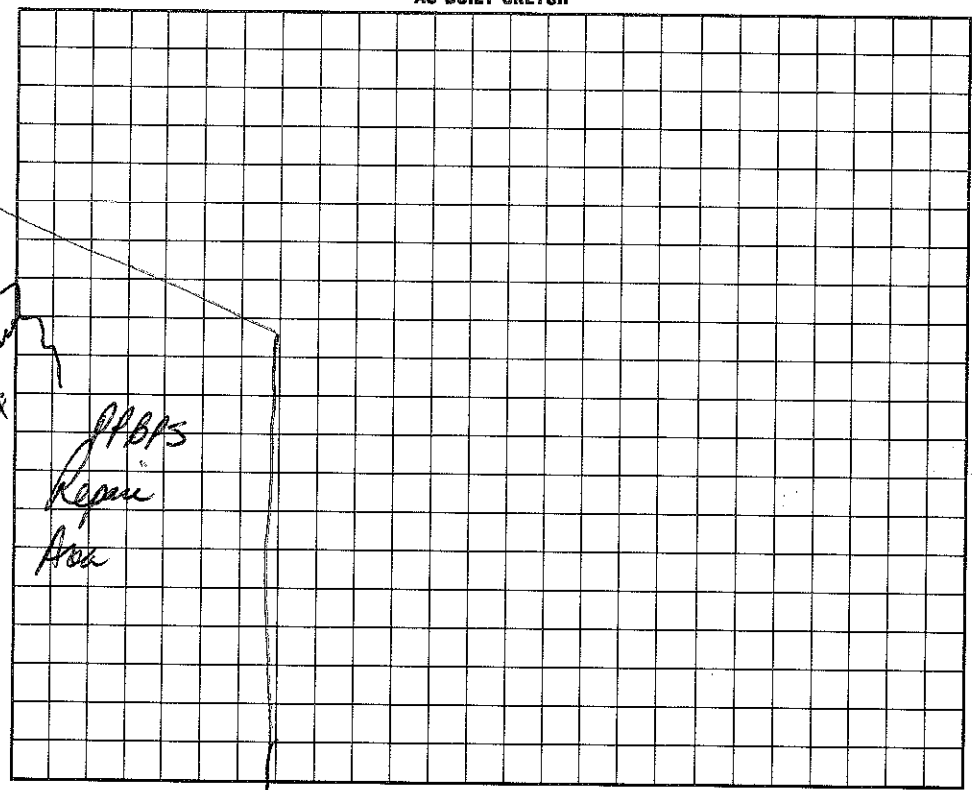

I understand that ~~this permit can be suspended or revoked if any false information is supplied toward securing the permit/any unauthorized changes are made to the site/any unauthorized changes are made in the installation of the system.~~ Improvement Permit is valid for 60 months from date of issuance.

Signed: [signature]

Improvement Permit by: [signature], HS date 8/1/94

Existing System Inspection by: ____ date ____

Installed by: ____

Certificate of Completion by: ____ date ____

Operation Permit by: [signature], HS date 12/6/94

HEALTH DEPT. COPY: WHITE INSPECTION COPY (FINAL): GREEN OWNER COPY (FINAL): YELLOW INSPECTION COPY (INITIAL): PINK OWNER COPY (INITIAL): GOLD