IREDELL COUNTY HEALTH DEPARTMENT

STATESVILLE 704-878-5305 MOORESVILLE 704-664-5281

IMPROVEMENT PERMIT / CERTIFICATE OF COMPLETION / OPERATION PERMIT / EXISTING SYSTEM INSPECTION

PROPERTY DESCRIPTION NO. 15671 DATE June 11, 93 TAX MAP NO. 2A-6-A-13

OWNER OR CONTRACTOR Jack A. Henriquez PHONE: Business _____ Home 4645 33 0753

ADDRESS _____

LOCATION 115 S. TR 1102 (Langtree) TR into Carson's Place bear right at lake on left next to last lot

SUBDIVISION Carson's Place BLOCK / SECTION _____ LOT 17 LOT AREA _____ SITE CLASS. _____ L.T.A.R. _____

Water Supply: ☑ Individual ☐ Community ☐ Public

Septic Tank: 1500 Gallons; STB 797 Date 5-1-93

Pump Tank: 1500 Gallons; PT 797 Date 3-30-93

Nitrification Field: No Fields 1 Square Feet 1600 Linear Feet 534

No Lines 7 Trench Width 36" Trench Depth ~36" Gravel Depth 12"

☑ New System ☐ Repair System Type: I, II, (III) IV, V, VI

System Description: Pressure manifold

Repair System Description: SAME OR LP PANEL

Maintenance Agreement Required: ☐ Yes ☑ No

☑ House/Mod. Home No. Bedrooms 4

☐ Mobile Home No. Bathrooms 3

☐ Business No. Employees —

☐ Other _____

☐ Slab ☐ Crawl Space ☑ Basement w/plumbing ☐ Basement wo/plumbing

Garbage Disposal: ☑ Yes ☐ No


Auto. Dishwasher: ☑ Yes ☐ No

Auto. Washing Machine: ☑ Yes ☐ No


Other _____

Comments pump line size reduced to 2"; No pubber pressurizing system.

INITIAL SITE SKETCH

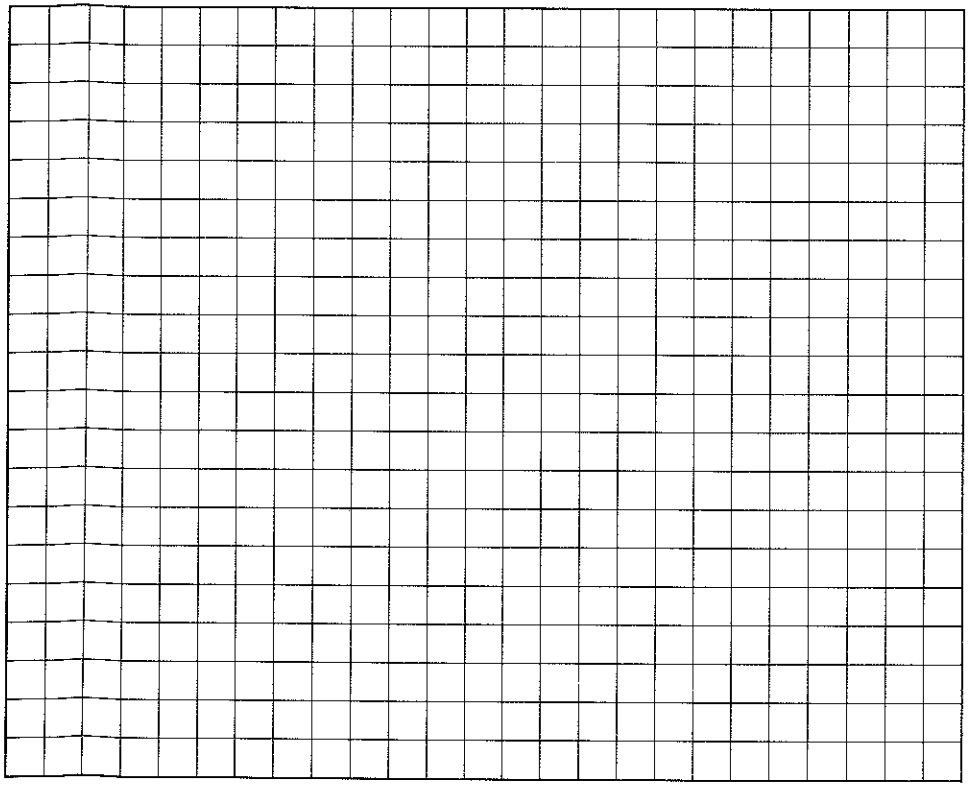

AS BUILT SKETCH

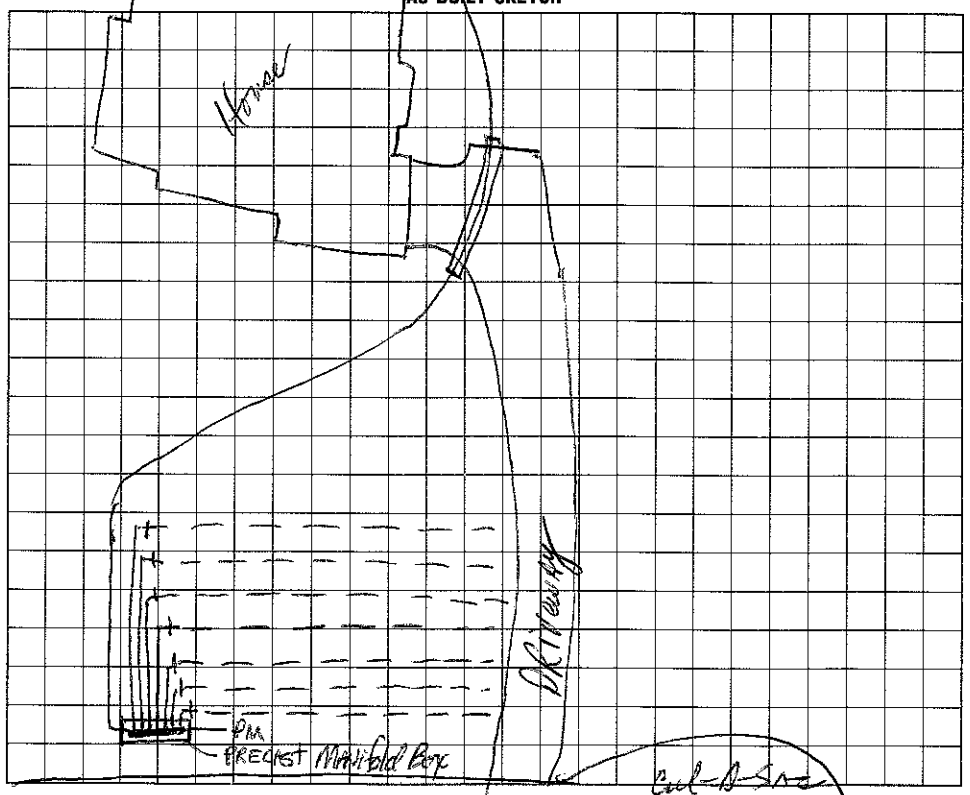

I understand that this permit can be suspended or revoked if any false information is supplied toward securing the permit/any unauthorized changes are made to the site/any unauthorized changes are made in the installation of the system. Improvement Permit is valid for 60 months from date of issuance.

Signed: _____ Installed by: Bob Mayfield

Improvement Permit by: _____ date _____ Certificate of Completion by: _____ date _____

Existing System Inspection by: _____ date _____ Operation Permit by: _____ date 6/11/93

HEALTH DEPT. COPY: WHITE INSPECTION COPY (FINAL): GREEN OWNER COPY (FINAL): YELLOW INSPECTION COPY (INITIAL): PINK OWNER COPY (INITIAL): GOLD