IREDELL COUNTY HEALTH DEPARTMENT

STATESVILLE 704-878-5305 MOORESVILLE 704-664-5281

IMPROVEMENT PERMIT / CERTIFICATE OF COMPLETION / OPERATION PERMIT / EXISTING SYSTEM INSPECTION

PROPERTY DESCRIPTION NO. 18463 DATE May 23, '94 TAX MAP NO. 2H11A17

OWNER OR CONTRACTOR R.M. Hazelwood PHONE: Business

ADDRESS 255 Water Hill Rd. Pa. 19341 Home 4645-34-2885

LOCATION 1206 (Alcove) Rt 1108 (Completion) TL Harwell Rd. Bear Rt. on Queens Circle n 500' on left Watershed: ☐ Yes ☐ No

SUBDIVISION Queens Cove BLOCK / SECTION 1 LOT 17 LOT AREA 22,000 ft² SITE CLASS. PB DESIGN FLOW 360 gpd L.T.A.R. .03

Septic Tank: 1000 Gallons; STB 797 Wellcraft Date 3-1-95

Pump Tank: Gallons; PT Date

Pump Make: Model Serial No.

Nitrification Field: No Fields 1 Square Feet 1200 Linear Feet 400

No Lines 5 Trench Width 36" Max Trench Bottom Depth 36" Gravel Depth 12"

☑ New System ☐ Repair System Type: I, II, III, IV, V, VI

System Description: gravity conventional

Repair System Description: pumped over w/ PTOPS

Maintenance Agreement Required: ☐ Yes ☑ No

☐ Slab ☐ Crawl Space ☑ Basement w/plumbing ☐ Basement wo/plumbing

☑ House/Mod. Home ☐ Mobile Home ☐ Business ☐ Other


No. Bedrooms 3 No. Bathrooms 3 1/2 No. Employees

Water Supply: ☑ Individual ☐ Community ☐ Public


Comments:

Comments: Installed Substantially as Shown

INITIAL SITE SKETCH

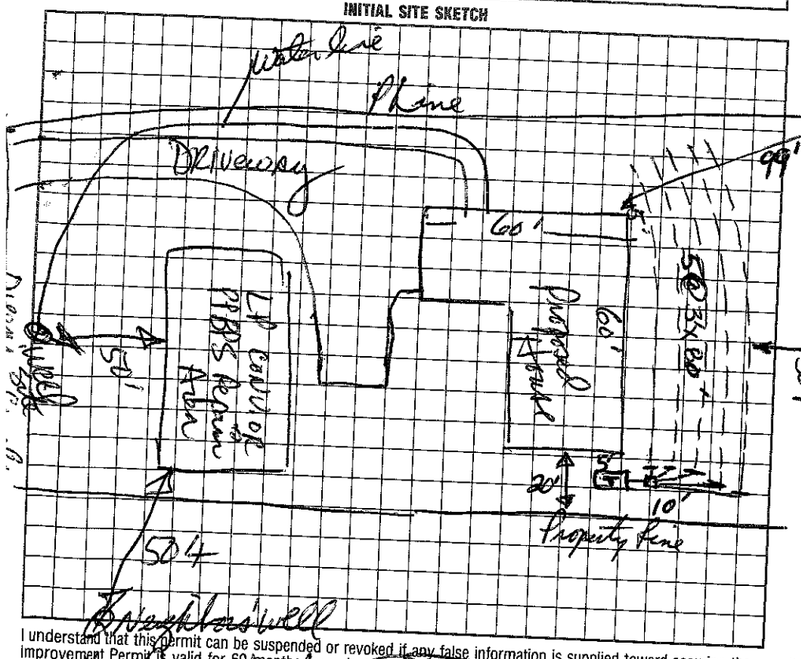

AS BUILT SKETCH

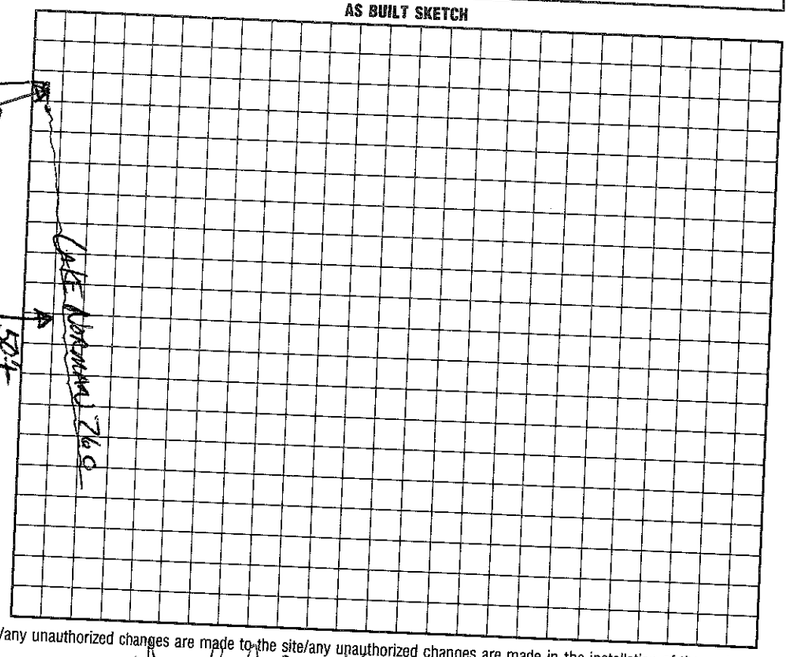

I understand that this permit can be suspended or revoked if any false information is supplied toward securing the permit/any unauthorized changes are made to the site/any unauthorized changes are made in the installation of the system. Improvement Permit is valid for 60 months from date of issuance.

Signed: R.M. Hazelwood

Improvement Permit by: Paul R Johnson, RS date 5/23/94

Existing System Inspection by: date

Installed by: MacLeod Const.

Certificate of Completion by: Johnson, RS date 6/21/95

Operation Permit by: date

HEALTH DEPT. COPY: WHITE INSPECTION COPY (FINAL): GREEN OWNER COPY (FINAL): YELLOW INSPECTION COPY (INITIAL): PINK OWNER COPY (INITIAL): GOLD