IREDELL COUNTY HEALTH DEPARTMENT

STATESVILLE 704-878-5305 / 130.00 Paid / MOORESVILLE 704-664-5281

IMPROVEMENT PERMIT / AUTHORIZATION TO CONSTRUCT / OPERATION PERMIT / EXISTING SYSTEM INSPECTION

PERMIT# 127849 PIN# 4645 36 0776 DATE 6/2/05

OWNER OR CONTRACTOR Corinthian Bldrs PHONE: Business _____ Home _____

ADDRESS PO Box 990

LOCATION Williamson, Turn Alcove TR Templeton, TL Camino Real, TL Queens Cove, on Lt.

SUBDIVISION Queens Cove BLOCK / SECTION 3 LOT 21 LOT AREA 2.236 AC SITE CLASS. PS DESIGN FLOW 480 L.T.A.R. 0.3

Septic Tank: 1000 Gallons; STB 786 Date 5/11/04
Pump Tank: 1000 Gallons; PT 40 Date 8/25/05
Pump Make: Goulds Model WE05111H Serial No. _____
Nitrification Field: No Fields 1 Square Feet 1200 Linear Feet 400'
No Lines 3@133' Trench Width 36" Max Trench Bottom Depth 36" Gravel Depth —

☒ New System ☐ Repair System Type: I, II, (III) IV, V, VI
System Description: PM 25% Reduction
Repair System Description: Same
Maintenance Agreement Required: ☐ Yes ☒ No

☒ House/Mod. Home No. Bedrooms 4
☐ Mobile Home No. Bathrooms ____
☐ Business No. Employees ____
☐ Other


☐ Slab ☐ Crawl Space ☐ Basement w/plumbing ☒ Basement wo/plumbing

Water Supply:
☒ Individual
☐ Public
☐ Community


Comments:/Conditions:
1"=100'

Comments:/Conditions:

INITIAL SITE SKETCH

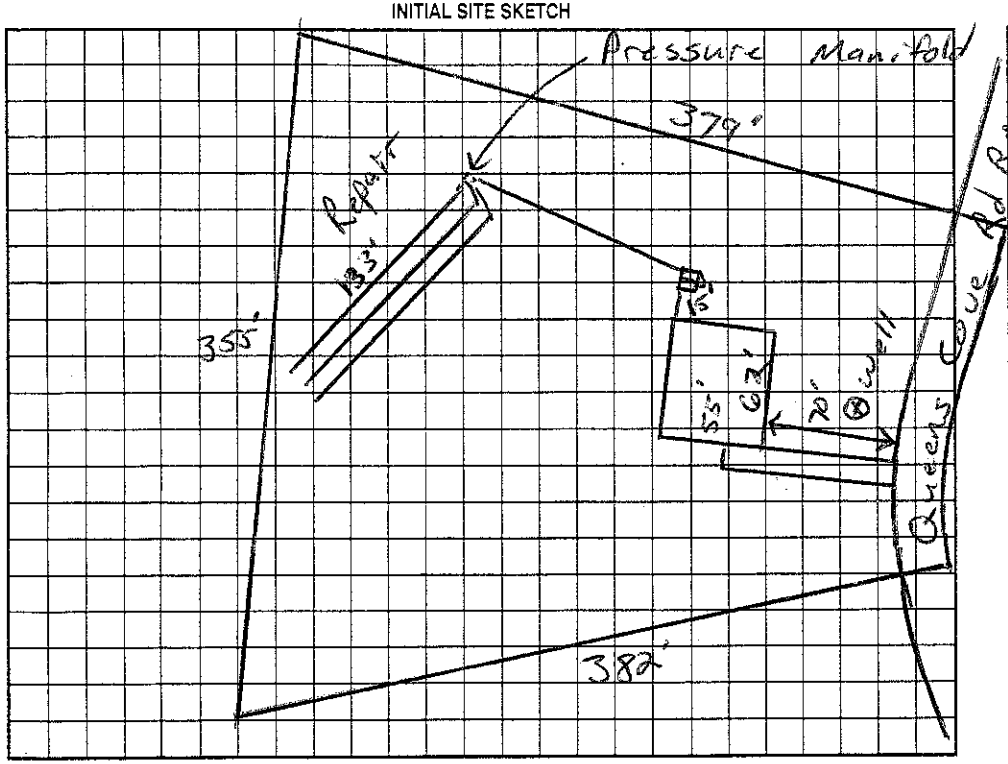

AS BUILT SKETCH

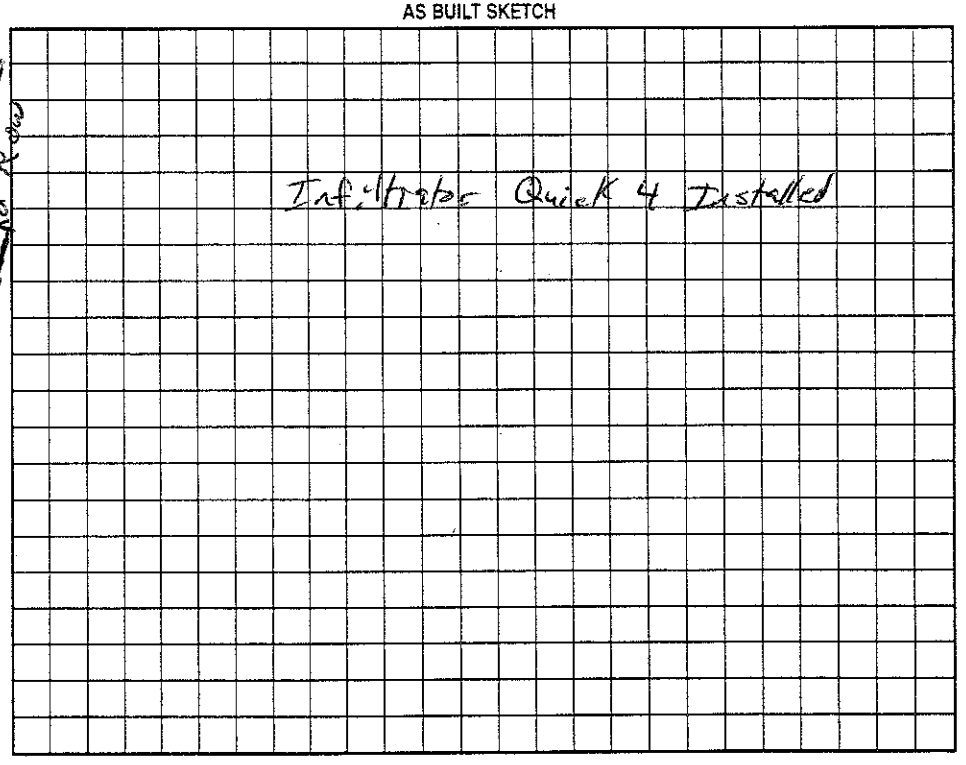

Permit can be suspended or revoked if any false information is supplied toward securing the permit/any unauthorized changes are made to the site/any unauthorized changes are made in the installation of the system. Improvement Permit with plat valid without expiration. Improvement Permit with site plan valid for sixty months. Authorization to Construct is valid for a period equal to that of Improvement Permit – not to exceed sixty months.

Signed: _____ date 6/9/05 Installed by: Corinthian Bldrs

Improvement Permit by: _____ RS date 6/2/05 Operation Permit by: _____ RS date 12/9/05

Authorization to Construct by: _____ RS date 6/2/05 Existing System Inspection by: _____ date _____

HEALTH DEPT COPY: WHITE OWNER COPY (FINAL): YELLOW OWNER COPY (INITIAL): PINK