IREDELL COUNTY HEALTH DEPARTMENT

STATESVILLE 704-878-5305 MOORESVILLE 704-664-5281

IMPROVEMENT PERMIT / AUTHORIZATION TO CONSTRUCT / OPERATION PERMIT / EXISTING SYSTEM INSPECTION

PERMIT# 135978 PIN# 4645 36 4416.000 DATE 6/14/06

OWNER OR APPLICANT GREG ERWIN PHONE: Business _____ Home 704-664-9232

ADDRESS 180 HARWELL DR MOORESVILLE NC 28117-7532

LOCATION ALCOVE TR TEMPLETON TL HARWELL ON R/F/180

SUBDIVISION QUEENS COVE BLOCK / SECTION _____ LOT 34 LOT AREA 2.16 SITE CLASS. PS DESIGN FLOW 600 L.T.A.R. _____

Septic Tank: 1500 EXISTING Date _____

Pump Tank: _____ Gallons; PT _____ Date _____

Pump Make: _____ Model _____ Serial No. _____

Nitrification Field: No Fields ___ Square EXISTING Linear Feet 600

No Lines 6 Trench Width 3' Max Trench Bottom Depth _____ Gravel Depth _____

☐ New System ☐ Repair ☐ Expansion System Type: I II III IV V VI

System Description: CONVENTIONAL

Repair System Description: 25% REDUCTION

Maintenance Agreement Required: ☐ Yes X No

☒ Gravity ☐ Pressure ☐ Slab ☒ Crawl Space ☐ Basement w/plumbing ☐ Basement w/o/plumbing

☒ House/Mod. Home No. Bedrooms 5

☐ Mobile Home No. Persons ___

☐ Business No. Employees ___

☐ Other GAR


Water Supply: ☒ Individual ☐ Public ☐ Community

Comments:/Conditions:

Comments:/Conditions:

INITIAL SITE SKETCH

AS BUILT SKETCH

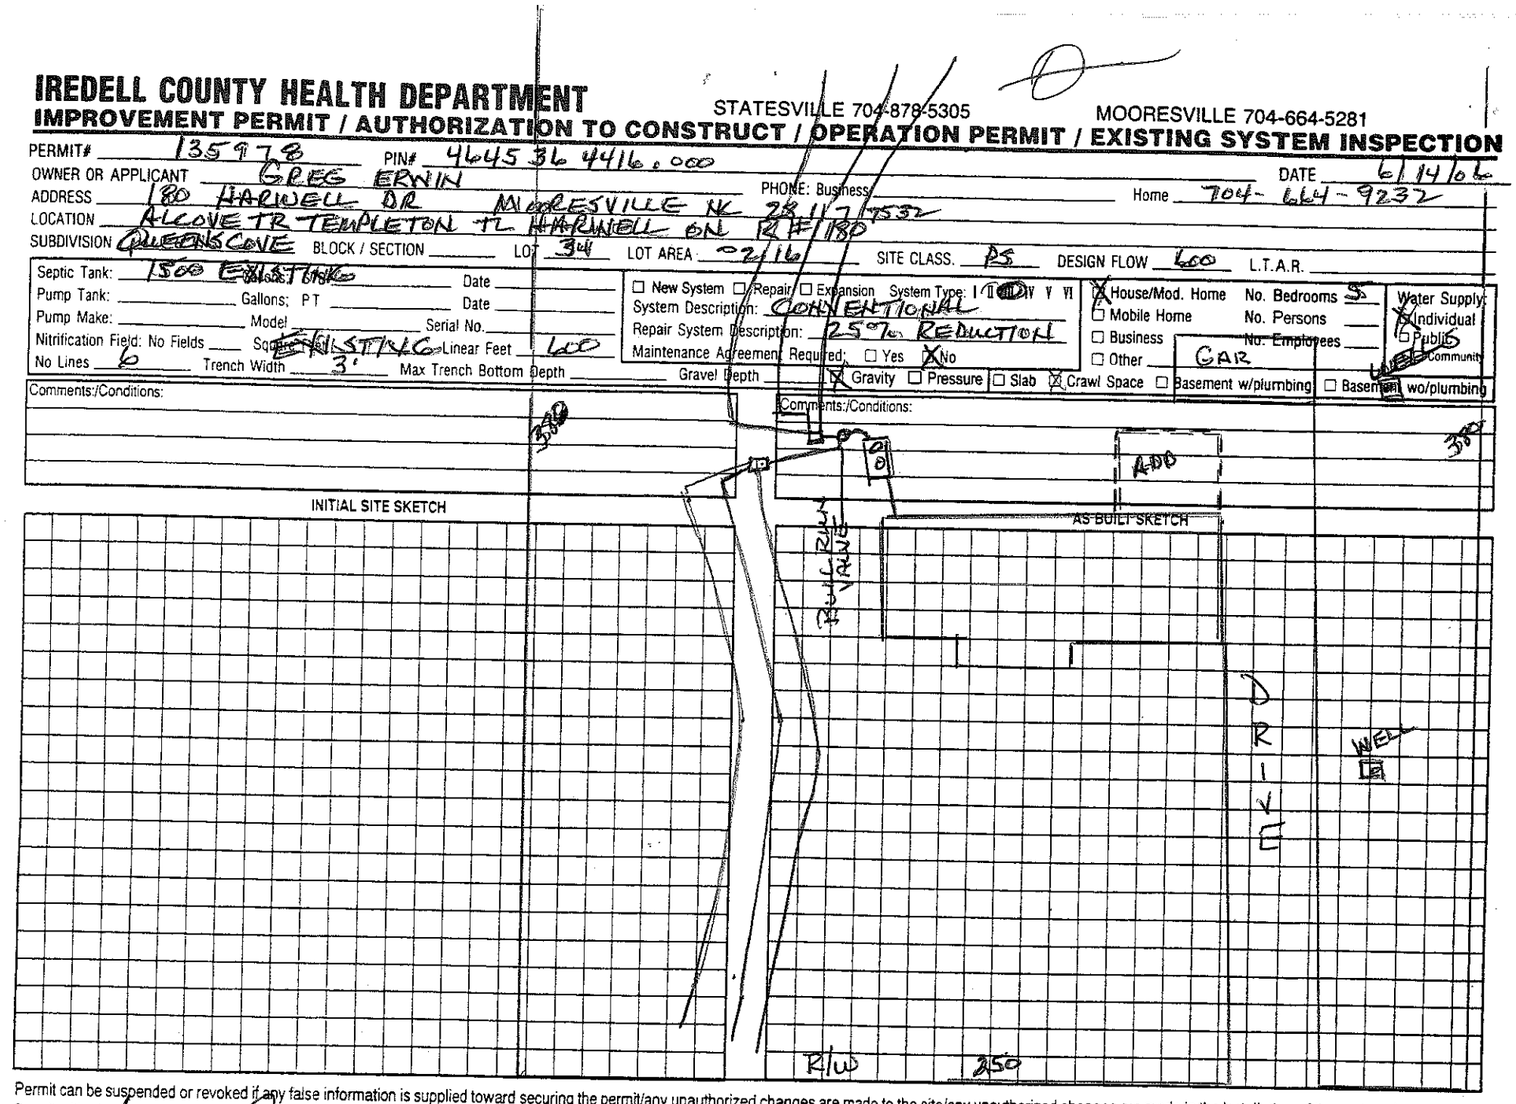

Permit can be suspended or revoked if any false information is supplied toward securing the permit/any unauthorized changes are made to the site/any unauthorized changes are made in the installation of the system. Improvement Permit with plat valid without expiration ☐ Improvement Permit with site plan valid for sixty months ☐ Authorization to Construct is valid for a period equal to that of Improvement Permit – not to exceed sixty months.

Signed: Susan Erwin date 6-15-06

Improvement Permit by: _____ date _____

Authorization to Construct by: _____ date _____

Installed by: _____

Operation Permit by: _____ date _____

Existing System Inspection by: Wesley Sparks RS date 6/14/06

HEALTH DEPT. COPY: WHITE OWNER COPY (FINAL): YELLOW OWNER COPY (INITIAL): PINK