IREDELL COUNTY HEALTH DEPARTMENT

IMPROVEMENT PERMIT / CERTIFICATE OF COMPLETION / OPERATION PERMIT / EXISTING SYSTEM INSPECTION

STATESVILLE 704-878-5305 MOORESVILLE 704-664-5281

PROPERTY DESCRIPTION NO. N/A DATE 3/17/97 TAX MAP NO.

OWNER OR CONTRACTOR Thomas Schaefer PHONE: Business Home 663-0726

ADDRESS 180 Harwell Dr. Mooresville NC 28115 Watershed: X Yes ☐ No

LOCATION Templeton Rd. TL on Harwell Rd. to 4th on (R) # 180

SUBDIVISION Quebec Cove BLOCK / SECTION LOT 34 LOT AREA SITE CLASS. PS DESIGN FLOW 360 L.T.A.R. .3

Septic Tank: Existing Syst Gallons; STB Date

Pump Tank: Gallons; PT Date

Pump Make: Model Serial No.

Notification Field: No Fields 1 Square Feet 1200 Linear Feet 400

No Lines 3 Trench Width 36" Max Trench Bottom Depth 36" Gravel Depth 12"

☐ New System X Repair System Type: I, II, III, IV, V, VI

System Description: Gravity Conventional - Dist Box

Repair System Description:

Maintenance Agreement Required: ☐ Yes X No

☐ Slab X Crawl Space ☐ Basement w/plumbing ☐ Basement wo/plumbing

X House/Mod. Home ☐ Mobile Home ☐ Business ☐ Other


No. Bedrooms 3 No. Bathrooms 3 No. Employees

Water Supply: X Individual ☐ Community ☐ Public

Comments:

Comments: SYSTEM LEFT OPEN OVER WEEKEND WITH HEAVY RAINS. TRENCHES WERE PUMPED OUT!

INITIAL SITE SKETCH

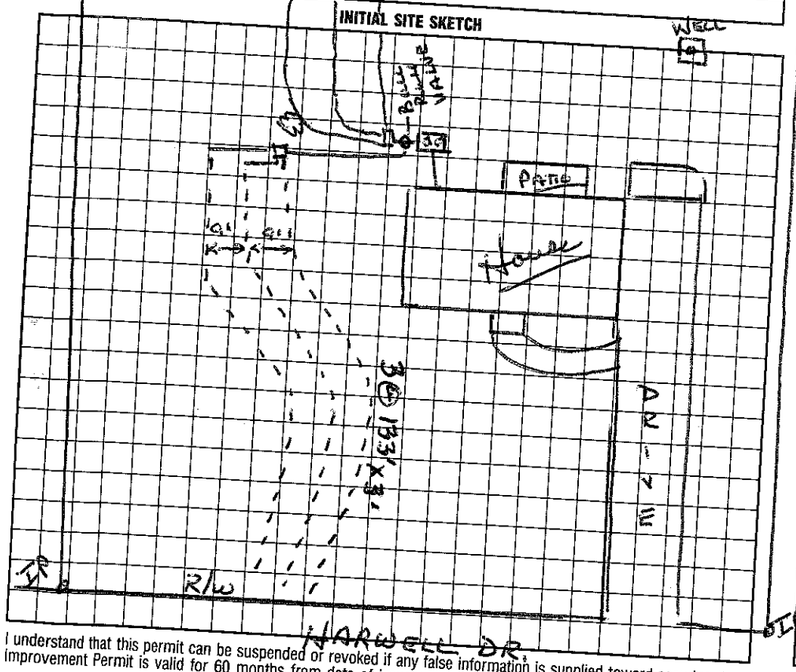

AS BUILT SKETCH

Same as Sketch

I understand that this permit can be suspended or revoked if any false information is supplied toward securing the permit/any unauthorized changes are made to the site/any unauthorized changes are made in the installation of the system. Improvement Permit is valid for 60 months from date of issuance.

Signed:

Improvement Permit by: date

Existing System Inspection by: Asst: Wesley Sparks RS date 3/17/97

Installed by: RICHARD ABERNATHY

Certificate of Completion by: date

Operation Permit by: C. Blythe date 4/30/97

HEALTH DEPT. COPY: WHITE INSPECTION COPY (FINAL): GREEN OWNER COPY (FINAL): YELLOW INSPECTION COPY (INITIAL): PINK OWNER COPY (INITIAL): GOLD