IREDELL COUNTY HEALTH DEPARTMENT

STATESVILLE 704-878-5305 MOORESVILLE 704-664-5281

IMPROVEMENT PERMIT / CERTIFICATE OF COMPLETION / OPERATION PERMIT / EXISTING SYSTEM INSPECTION

PROPERTY DESCRIPTION NO. NIA DATE 3/17/97 TAX MAP NO. Watershed: [X] Yes [ ] No

OWNER OR CONTRACTOR Thomas Schaefer PHONE: Business Home 663-0726

ADDRESS 180 Harwell Dr. Mooresville, NC. 28115

LOCATION Templeton Rd. TL on Harwell Rd. to [illegible] on (R) # 180

SUBDIVISION Queens Cove BLOCK / SECTION LOT 34 LOT AREA SITE CLASS. PS DESIGN FLOW 360 L.T.A.R. .3

Septic Tank: Existing Syst Gallons; STB Date

Pump Tank: Gallons; PT Date

Pump Make: Model Serial No.

Nitrification Field: No. Fields 1 Square Feet 1200 Linear Feet 400

No. Lines 3 Trench Width 36" Max Trench Bottom Depth 36" Gravel Depth 12"

[ ] New System [X] Repair System Type: I, II, III, IV, V, VI

System Description: Straw Conventional - Dirt Bed

Repair System Description:

Maintenance Agreement Required: [ ] Yes [X] No

[X] House/Mod. Home No. Bedrooms 3

[ ] Mobile Home No. Bathrooms 3

[ ] Business No. Employees

[ ] Other


[ ] Slab [X] Crawl Space [ ] Basement w/plumbing [ ] Basement wo/plumbing

Water Supply: [X] Individual [ ] Community [ ] Public


Comments:

Comments: SYSTEM LEFT OPEN OVER WEEKEND WITH HEAVY RAINS. TRENCHES WERE PUMPED OUT.

INITIAL SITE SKETCH

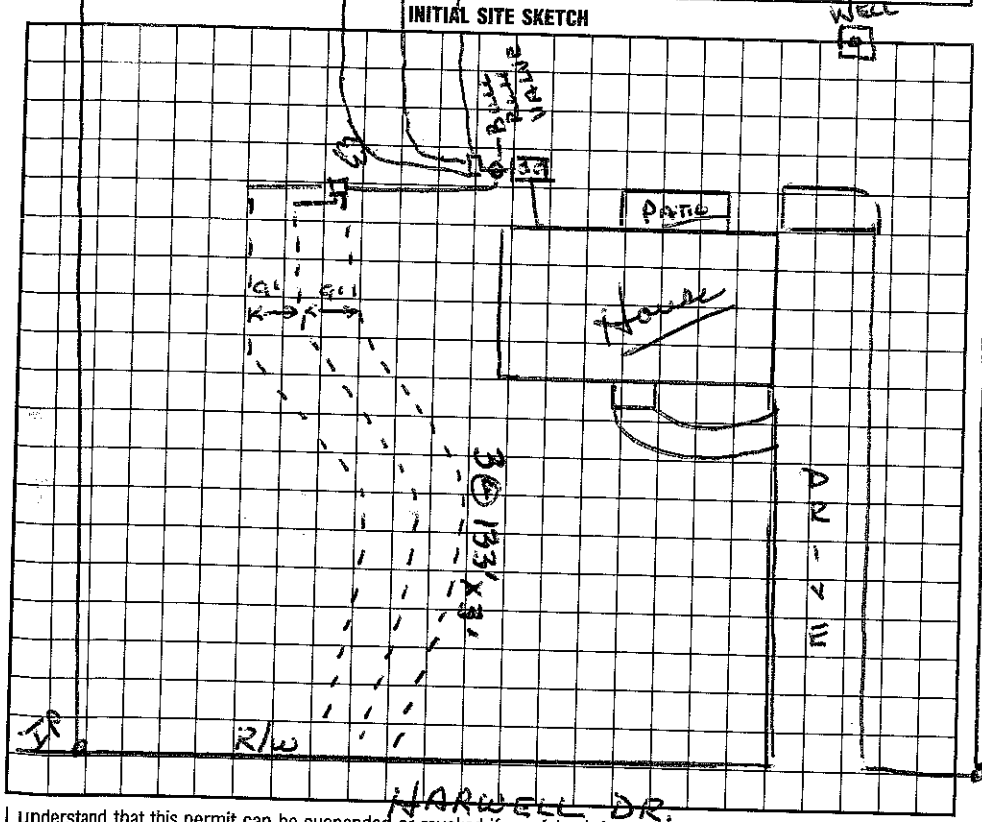

AS BUILT SKETCH

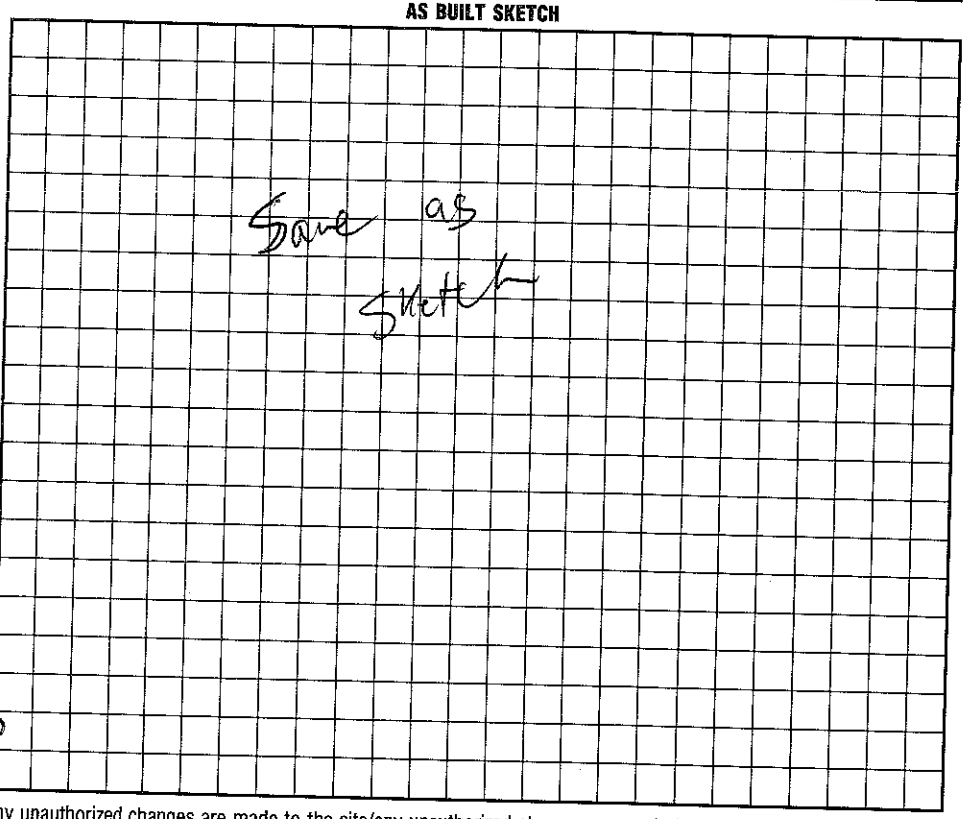

I understand that this permit can be suspended or revoked if any false information is supplied toward securing the permit/any unauthorized changes are made to the site/any unauthorized changes are made in the installation of the system. Improvement Permit is valid for 60 months from date of issuance.

Signed:

Improvement Permit by: date

Existing System Inspection by: Instruct: Wesley Sparks RS date 3/17/97

Installed by: RICHARD ABERNATHY

Certificate of Completion by: date

Operation Permit by: C. Bly Toomer date 4/30/97

HEALTH DEPT. COPY: WHITE INSPECTION COPY (FINAL): GREEN OWNER COPY (FINAL): YELLOW INSPECTION COPY (INITIAL): PINK OWNER COPY (INITIAL): GOLD