IREDELL COUNTY HEALTH DEPARTMENT - *ENVIRONMENTAL HEALTH* ☐ STATESVILLE OFFICE 704-878-5305 ☑ MOORESVILLE OFFICE 704-664-5281

IMPROVEMENT PERMIT / AUTHORIZATION TO CONSTRUCT / OPERATION PERMIT / EXISTING SYSTEM INSPECTION

PERMIT # 171903 PIN # 4645-36-4730 DATE 5-14-12

OWNER DAVID, DENNIS APPLICANT: SAME PHONE: Home/Cell # 704-262-3659 Business #

SITE ADDRESS 000 HARWELL RD OWNER / APPLICANT ADDRESS 4654 ROCKY HOLLOW RD DAVIDSON

SITE DIRECTIONS ALCOVE TO TEMPLETON TO HARWELL, ON R

SUBDIVISION QUEEN'S COVE BLOCK / SECTION 2 LOT # 35 LOT AREA 1.931 AC DESIGN FLOW 480 GPD L.T.A.R. 3

Septic Tank 1000 Gallons: STB 760 Date 11-10

Pump Tank Gallons: P T Date

Pump Make Model Serial #

No. Nitrification Fields: 1 No. Lines 4 Linear Feet 400'

Trench Width 36" Max. Trench Bottom Depth 36"

☒ New System ☐ Repair ☐ Expansion System Type I II (III) IV V VI

System Description: GRAVITY 25%

Repair System Description: SAME

Maintenance Agreement Required ☐ YES ☒ NO

Gravel Depth ☒ GRAVITY ☐ PRESSURE

☒ Residence No. Bedrooms 4

☐ Business No. Persons

☐ Other No. Employees


☐ Slab ☒ Crawl Space

☐ Basement w/plumbing ☐ Basement w/o plumbing


Water Supply: ☒ Private ☐ Public ☐ Community

Comments / Conditions ① SEPTIC MUST BE 15' OFF OF POOL AREA

INITIAL SITE SKETCH

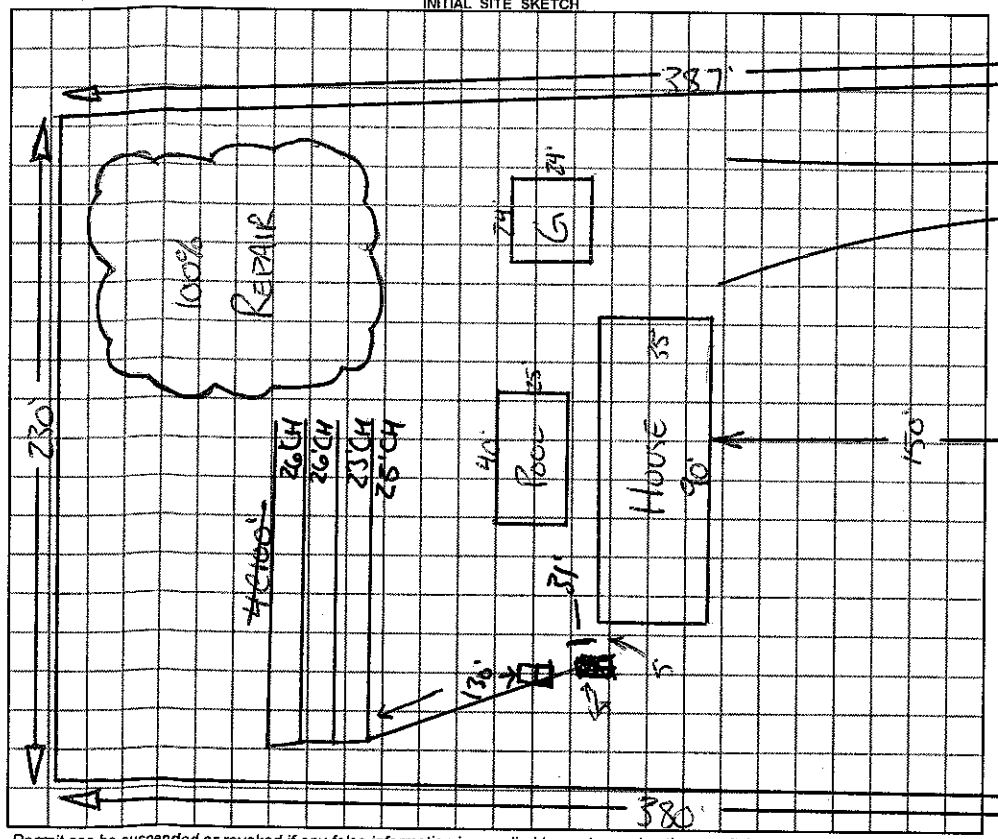

AS BUILT SKETCH

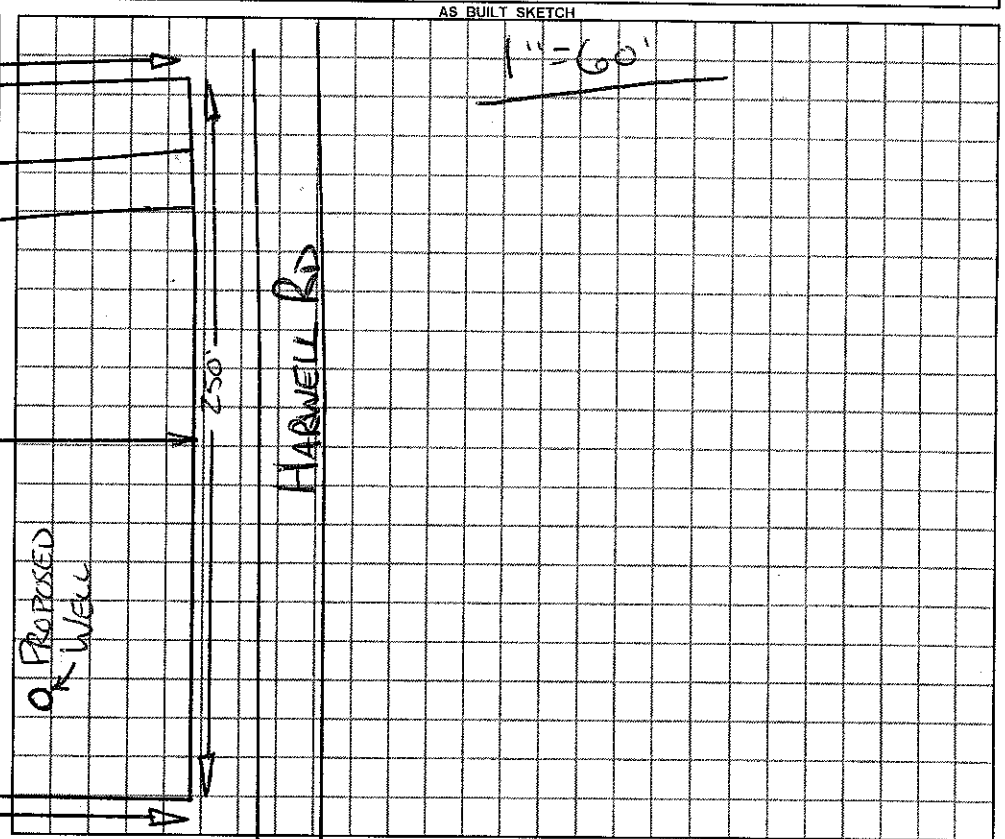

Permit can be suspended or revoked if any false information is supplied toward securing the permit / any unauthorized changes are made to the site / any unauthorized changes are made in the installation of the system.

☐ *IMPROVEMENT PERMIT with plat valid without expiration.* ☒ *IMPROVEMENT PERMIT with ~~plat valid without expiration.~~ site plan valid 60 mo.* ☒ *AUTHORIZATION TO CONSTRUCT* valid for period equal to IMPROVEMENT PERMIT--not to exceed 60 mo.

Owner / Applicant Signature: Date 5-16-12 Installed by:

IMPROVEMENT PERMIT by: REHS Date 5-15-12 OPERATION PERMIT by: REHS Date 5-22-13

AUTHORIZATION TO CONSTRUCT by: REHS Date 5-17-12 Existing System Inspected by: REHS Date

YOU SHOULD CONTACT A LOCATOR SERVICE PRIOR TO ANY EXCAVATION

White Copy – Environmental Health YELLOW COPY (Final) Owner / Applicant PINK COPY (Initial) Owner / Applicant