IREDELL COUNTY HEALTH DEPARTMENT

STATESVILLE 704-878-5305 MOORESVILLE 704-664-5281

IMPROVEMENT PERMIT / AUTHORIZATION TO CONSTRUCT / OPERATION PERMIT / EXISTING SYSTEM INSPECTION

PERMIT# 07703 PIN# 4645 36 4943 DATE 11/18/98

OWNER OR CONTRACTOR Newman McDade Builders PHONE: Business 892-7991 Home

ADDRESS PO Box 131 Mt Mourne, NC. 28123

LOCATION Williamson Rd, TR Alcove Rd. TR Templeton, TL Harwell lot on (R)

SUBDIVISION Queens Cove BLOCK / SECTION 2 LOT 36 LOT AREA 2.13 SITE CLASS. PS DESIGN FLOW 480 L.T.A.R. .3

Septic Tank: 1000 Gallons; STB Date
Pump Tank: Gallons; PT Date
Pump Make: Model Serial No.
Nitrification Field: No Fields 1 Square Feet 1600 Linear Feet 533'
No Lines 4 Trench Width 36" Max Trench Bottom Depth 36" Gravel Depth SAND.

☒ New System ☐ Repair System Type: I, II, III, IV, V, VI
System Description: Deep Conventional
Repair System Description: Same
Maintenance Agreement Required: ☐ Yes ☒ No


☒ House/Mod. Home No. Bedrooms 4
☐ Mobile Home No. Bathrooms 3
☐ Business No. Employees
☐ Other
☐ Slab ☒ Crawl Space ☐ Basement w/plumbing ☐ Basement wo/plumbing

Water Supply: ☒ Individual ☐ Public ☐ Community


Comments:/Conditions:

Comments:/Conditions:

INITIAL SITE SKETCH

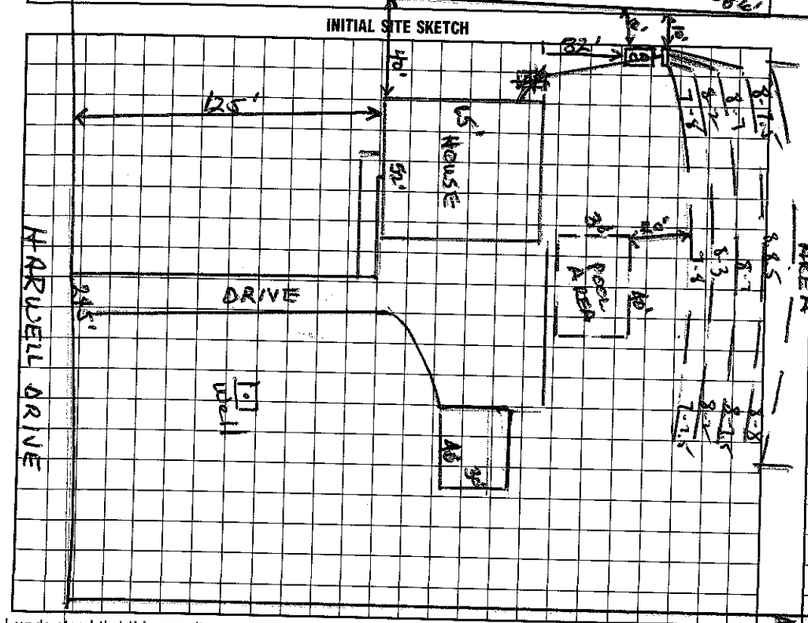

AS BUILT SKETCH

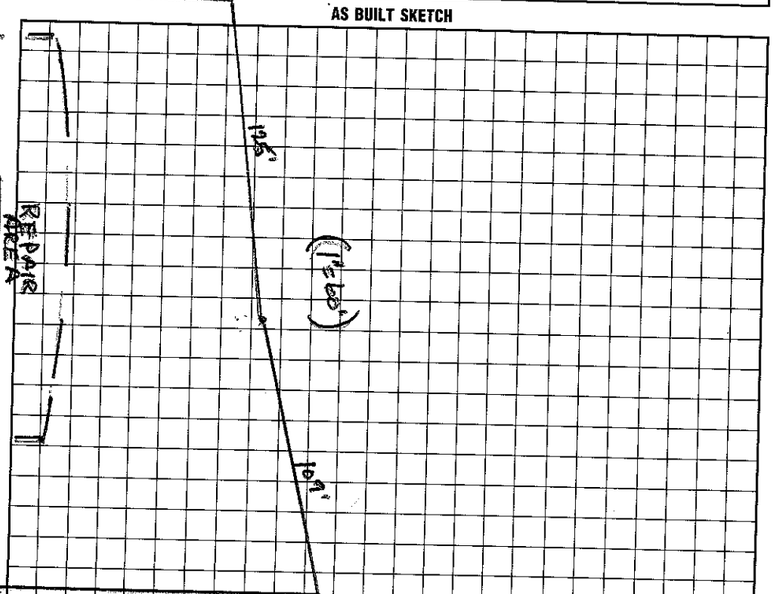

I understand that this permit can be suspended or revoked if any false information is supplied toward securing the permit/any unauthorized changes are made to the site/any unauthorized changes are made in the installation of the system. Improvement Permit with plat valid without expiration. Improvement Permit with site plan valid for sixty months. Authorization to Construct is valid for a period equal to that of Improvement Permit – not to exceed sixty months.

Signed: Newman McDade date 11/30/98

Improvement Permit by: Wesley Sparks RS. date 11/18/98

Authorization to Construct by: Wesley Sparks RS. date 11/18/98

Installed by: Richard Abernathy

Operation Permit by: Wesley Sparks RS. date 10/1/99

Existing System Inspection by: date

HEALTH DEPT. COPY: WHITE INSPECTION COPY (FINAL): GREEN OWNER COPY (FINAL): YELLOW INSPECTION COPY (INITIAL): PINK OWNER COPY (INITIAL): GOLD