3:00 pm

IREDELL COUNTY HEALTH DEPARTMENT - *ENVIRONMENTAL HEALTH* ☐ STATESVILLE OFFICE 704-878-5305 ☐ MOORESVILLE OFFICE 704-664-5281

IMPROVEMENT PERMIT / AUTHORIZATION TO CONSTRUCT / OPERATION PERMIT / EXISTING SYSTEM INSPECTION

PERMIT # 168907 PIN # 4645372877 DATE 10-31-2011

OWNER Richard Wozny APPLICANT: Same PHONE: Home/Cell # 704663-6813 Business # 704650-1720

SITE ADDRESS Templeton Rd OWNER / APPLICANT ADDRESS 112 Sumter Dr. Mooresville, NC

SITE DIRECTIONS Williamson Rd TL Alcove TR Templeton on left just pass Harwell Dr

SUBDIVISION Queens Cove BLOCK / SECTION LOT # 14 LOT AREA 2.203 Acre DESIGN FLOW 240gpd L.T.A.R. = 3

Septic Tank 1000 Gallons: STB 312 Date 7-12-12

Pump Tank Gallons: P T Date

Pump Make Model Serial #

No. Nitrification Fields: 1 No. Lines 2 Linear Feet 26'T'

Trench Width 36" Max. Trench Bottom Depth 36" Gravel Depth 12"

☒ New System ☐ Repair ☐ Expansion System Type I II III IV V VI

System Description: ☒ Gravity - Conventional

Repair System Description: Same

Maintenance Agreement Required ☐ YES ☒ NO

☒ GRAVITY ☐ PRESSURE

☒ Residence No. Bedrooms 2

☐ Business No. Persons

☐ Other No. Employees

☒ Slab ☐ Crawl Space


☐ Basement w/plumbing ☐ Basement w/o plumbing

Water Supply: ☒ Private ☐ Public ☐ Community


Comments / Conditions: Must keep Septic System 100Ft From any well & 10Ft From PL

☒ Okay to use 200Ft of -25% Reduction Use ARC 36 Plastic Chamber w/ Dist box 2-100Ft lines Installed as Drawn

INITIAL SITE SKETCH

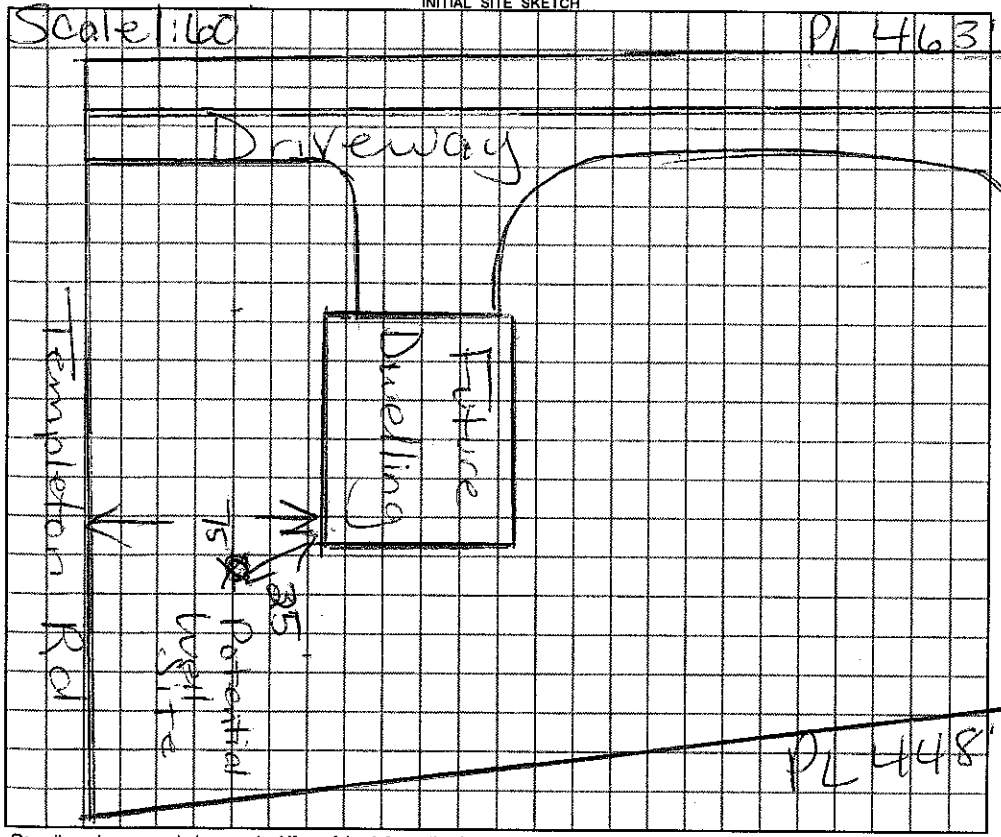

AS BUILT SKETCH

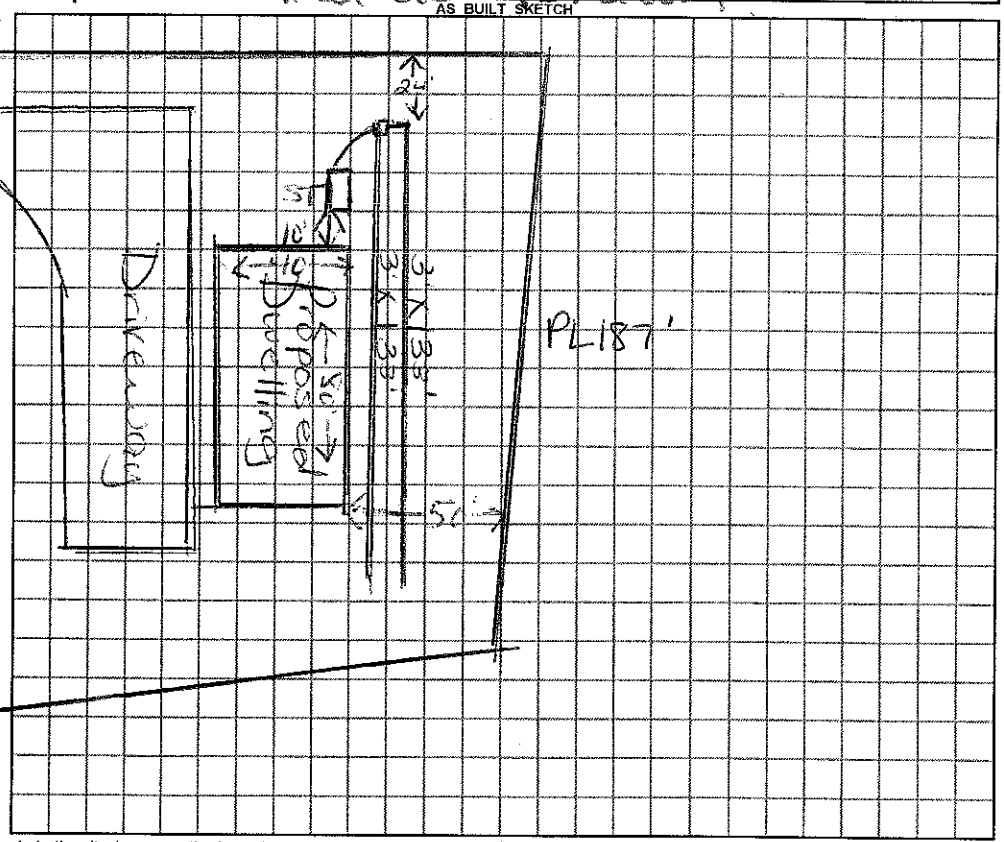

Permit can be suspended or revoked if any false information is supplied toward securing the permit / any unauthorized changes are made to the site / any unauthorized changes are made in the installation of the system.

☐ ***IMPROVEMENT PERMIT*** with plat valid without expiration. ☐ ***IMPROVEMENT PERMIT*** with ~~plat valid without expiration.~~ site plan valid 60 mo. ☐ ***AUTHORIZATION TO CONSTRUCT*** valid for period equal to IMPROVEMENT PERMIT--not to exceed 60 mo.

Owner / Applicant Signature: Richard Wozny RS Date

IMPROVEMENT PERMIT by: Maria REHS Date 10/31/11

AUTHORIZATION TO CONSTRUCT by: Maria REHS Date 10/31/11

YOU SHOULD CONTACT A LOCATOR SERVICE PRIOR TO ANY EXCAVATION

Installed by: E.J. Ervin

OPERATION PERMIT by: Maria REHS Date 8/27/12

Existing System Inspected by: REHS Date

White Copy – Environmental Health YELLOW COPY (Final) Owner / Applicant PINK COPY (Initial) Owner / Applicant