Neighbors

IREDELL COUNTY HEALTH DEPARTMENT

STATESVILLE 704-878-5305 MOORESVILLE 704-664-5281

IMPROVEMENT PERMIT / AUTHORIZATION TO CONSTRUCT / OPERATION PERMIT / EXISTING SYSTEM INSPECTIO

PERMIT# 081704 PIN# 4645 37 3505

OWNER OR CONTRACTOR Doug Richert PHONE: Business DATE 1/20/00

ADDRESS 126 Harwell Dr. Mooresville, NC. 28117 Home 664-4546

LOCATION Alcove Rd TR Templeton Rd TL Harwell Dr., 1st drive on (R)

SUBDIVISION Queens Cove BLOCK / SECTION 2 LOT 39 LOT AREA ~ 2.9 Ac SITE CLASS PS DESIGN FLOW 360 L.T.A.R. N/A

Septic Tank: EXISTING Gallons; STB Date

Pump Tank: Gallons; PT Date

Pump Make: Model Serial No.

Nitrification Field: No Fields Square EXISTING Linear Feet

No Lines Trench Width Max Trench Bottom Depth Gravel Depth

☐ New System ☐ Repair System Type: I, II, III, IV, V, VI

System Description: CONVENTIONAL

Repair System Description:

Maintenance Agreement Required: ☐ Yes ☒ No

☒ House/Mod. Home ☐ Mobile Home ☐ Business ☐ Other ADDING GARAGE

No. Bedrooms 3 No. Bathrooms 3 No. Employees


☐ Slab ☐ Crawl Space ☐ Basement w/plumbing ☐ Basement w/o plumbing

Water Supply: ☒ Individual ☐ Public ☐ Community


Comments/Conditions:

Comments/Conditions: REC ROOM W/ UNFINISHED UPSTAIRS AREA

INITIAL SITE SKETCH (1" = 50')

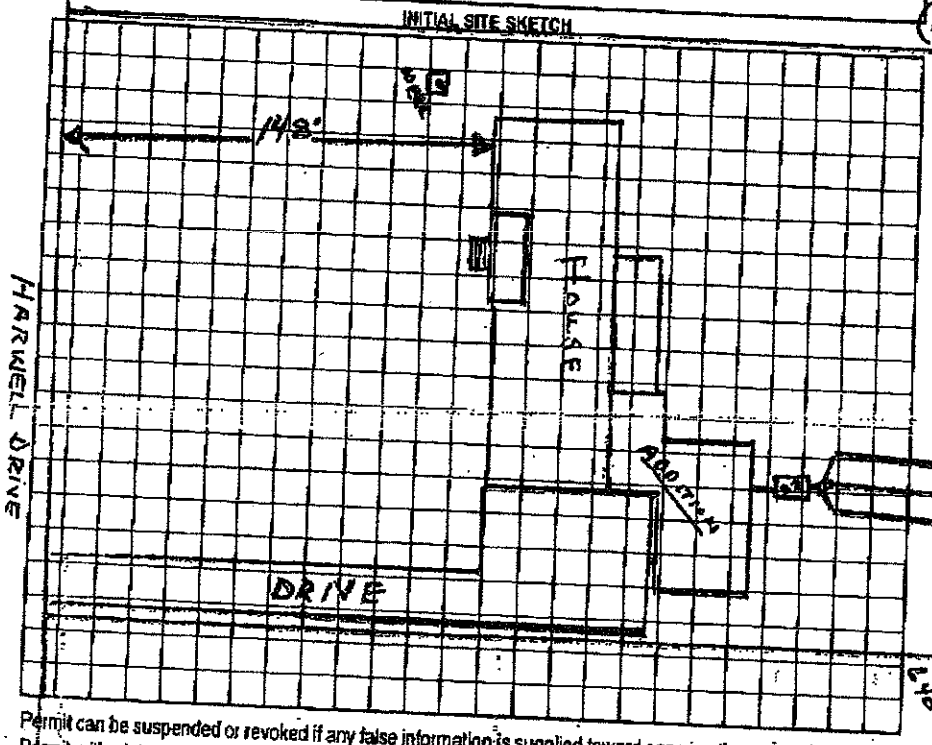

AS BUILT SKETCH

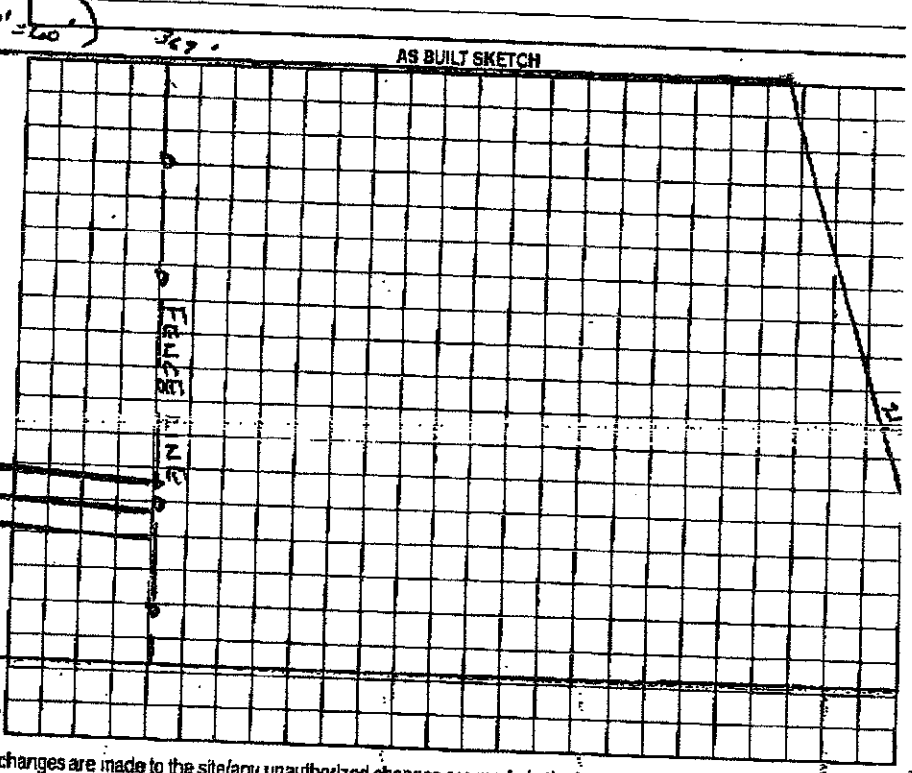

Permit can be suspended or revoked if any false information is supplied toward securing the permit/any unauthorized changes are made to the site/any unauthorized changes are made in the installation of the system. Improvement Permit with plat valid without expiration. Improvement Permit with site plan valid for sixty months. Authorization to Construct is valid for a period equal to that of Improvement Permit – not to exceed sixty months.

Signed: * Melanie Crouch date 1/28/00

Improvement Permit by: Wesley Sparks R.S. date 1/20/00

Authorization to Construct by: Wesley Sparks R.S. date 1/20/00

Installed by:

Operation Permit by: date

Existing System Inspection by: Wesley Sparks R.S. date 1/20/00

HEALTH DEPT. COPY: WHITE OWNER COPY (FINAL): YELLOW OWNER COPY (INITIAL): PINK

HARWELL DR. (STREET)

10/07/2011 09:30 7046523239 PAGE 02