IREDELL COUNTY HEALTH DEPARTMENT

STATESVILLE 704-878-5305 MOORESVILLE 704-664-5281

IMPROVEMENT PERMIT / CERTIFICATE OF COMPLETION / OPERATION PERMIT / EXISTING SYSTEM INSPECTION

PROPERTY DESCRIPTION NO. 26120 DATE 10/16/97 TAX MAP NO. 4645378703 Watershed: ☒ Yes ☐ No

OWNER OR CONTRACTOR Angelo & Joseph Johnston PHONE: Business _____ Home 660-5548

ADDRESS 150 Catalina Dr Mooresville, NC 28115

LOCATION _____

SUBDIVISION Queens Cove BLOCK / SECTION 2 LOT 12C LOT AREA 1.484 Acre SITE CLASS. P5 DESIGN FLOW 450gpd L.T.A.R. .3

Septic Tank: 1000 Gallons; STB 714 Date 8-12-97
Pump Tank: _____ Gallons; PT _____ Date _____
Pump Make: _____ Model _____ Serial No. _____
Nitrification Field: No Fields 1 Square Feet 1600 Linear Feet 533
No Lines 5 at 107' Trench Width 36" Max Trench Bottom Depth 36" Gravel Depth 12"

☒ New System ☐ Repair System Type: I, (II), III, IV, V, VI
System Description: Gravity Conventional
Repair System Description: Pump Conventional
Maintenance Agreement Required: ☐ Yes ☐ No

☒ House/Mod. Home No. Bedrooms 4
☐ Mobile Home No. Bathrooms 3
☐ Business No. Employees ____
☐ Other _____


☐ Slab ☐ Crawl Space ☐ Basement w/plumbing ☐ Basement wo/plumbing

Water Supply:
☒ Individual
☐ Community
☐ Public


Comments: As-Built

Comments: Initial System installed in repair area See attached "As Built"


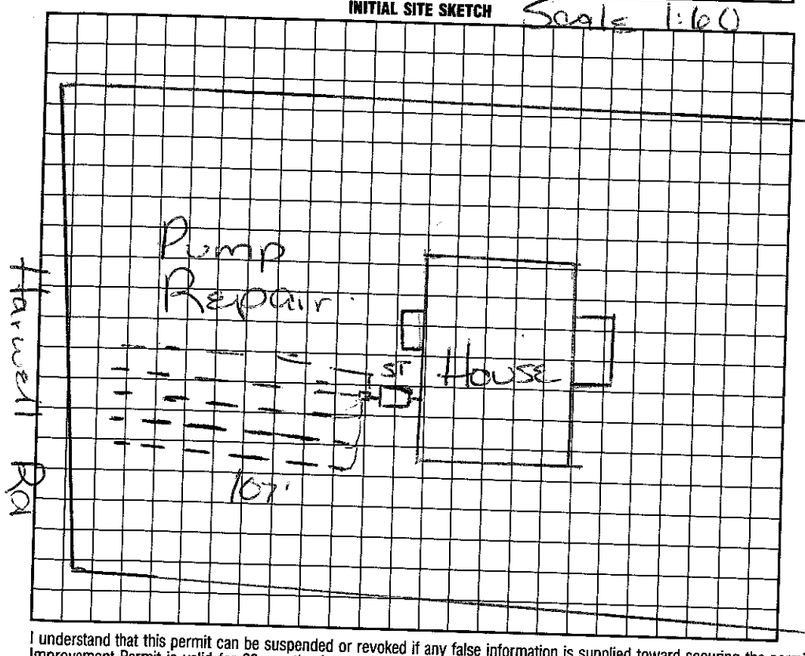

AS BUILT SKETCH

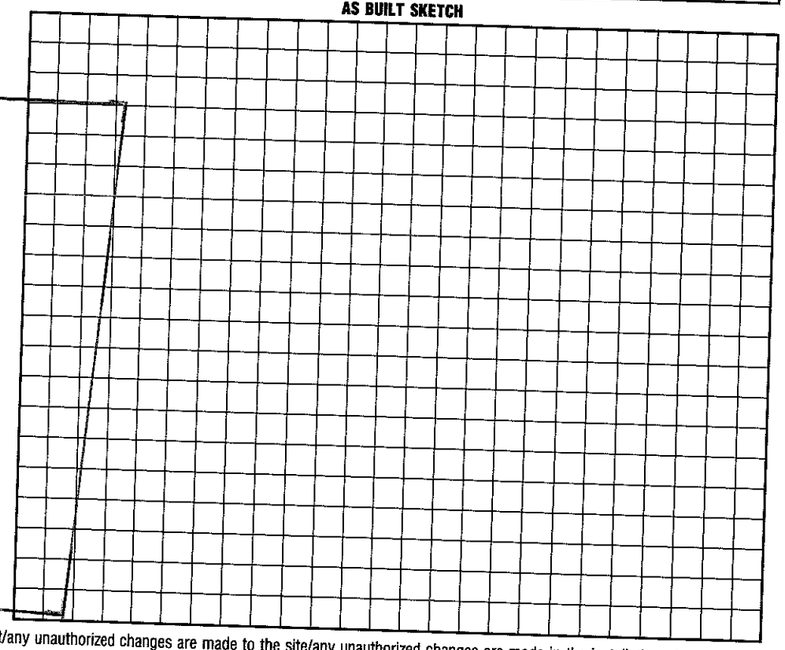

I understand that this permit can be suspended or revoked if any false information is supplied toward securing the permit/any unauthorized changes are made to the site/any unauthorized changes are made in the installation of the system. Improvement Permit is valid for 60 months from date of issuance.

Signed: _____

Improvement Permit by: _____ date _____

Existing System Inspection by: _____ date _____

Installed by: Larry Beam

Certificate of Completion by: Marshall H Dotson date 10/16/97

Operation Permit by: Marshall H Dotson date 10/16/97

HEALTH DEPT. COPY: WHITE INSPECTION COPY (FINAL): GREEN OWNER COPY (FINAL): YELLOW INSPECTION COPY (INITIAL): PINK OWNER COPY (INITIAL): GOLD

IREDELL COUNTY HEALTH DEPARTMENT

Authorization to Construct

9:30

STATESVILLE 704-878-5305 MOORESVILLE 704-664-5281

IMPROVEMENT PERMIT / ~~CERTIFICATE OF COMPLETION~~ / OPERATION PERMIT / EXISTING SYSTEM INSPECTION

PROPERTY DESCRIPTION NO. 26120 DATE 2/10/97 TAX MAP NO. 4645 37 8913 Watershed: ☒ Yes ☐ No

OWNER OR CONTRACTOR Angela & Joseph Johnston PHONE: Business _____ Home 660-5548

ADDRESS 150 Cutchin Dr. Mooresville, NC. 28115

LOCATION W. Plemmons Rd. TR Deans TR Templeton Rd TL Hiewall Rd. to 1st lot on (L)

SUBDIVISION Queens Cove BLOCK / SECTION _____ LOT 12C LOT AREA 1.484 SITE CLASS. PS DESIGN FLOW 480 L.T.A.R. .5

Septic Tank: 1000 Gallons; STB 1911 Date 2-12-97

Pump Tank: _____ Gallons; PT _____ Date _____

Pump Make: _____ Model _____ Serial No. _____

Nitrification Field: No Fields 1 Square Feet 1600 Linear Feet 533

No Lines ~~5~~ 5 Trench Width 36" Max Trench Bottom Depth 36" Gravel Depth 12"

☒ New System ☐ Repair System Type: I, II, III, IV, V, VI

System Description: Drainfield - Conventional

Repair System Description: None

Maintenance Agreement Required: ☐ Yes ☒ No

☐ Slab ☒ Crawl Space ☐ Basement w/plumbing ☐ Basement wo/plumbing

☒ House/Mod. Home No. Bedrooms 4

☐ Mobile Home No. Bathrooms 3

☐ Business No. Employees ____

☐ Other _____


Water Supply: ☒ Individual ☐ Community ☐ Public

Comments: 10/7/97 - Plumbing stub out in wrong location - S/T and drainfield moved 10 Feet.


Comments:

Drainfield located in "Repair Area"

INITIAL SITE SKETCH

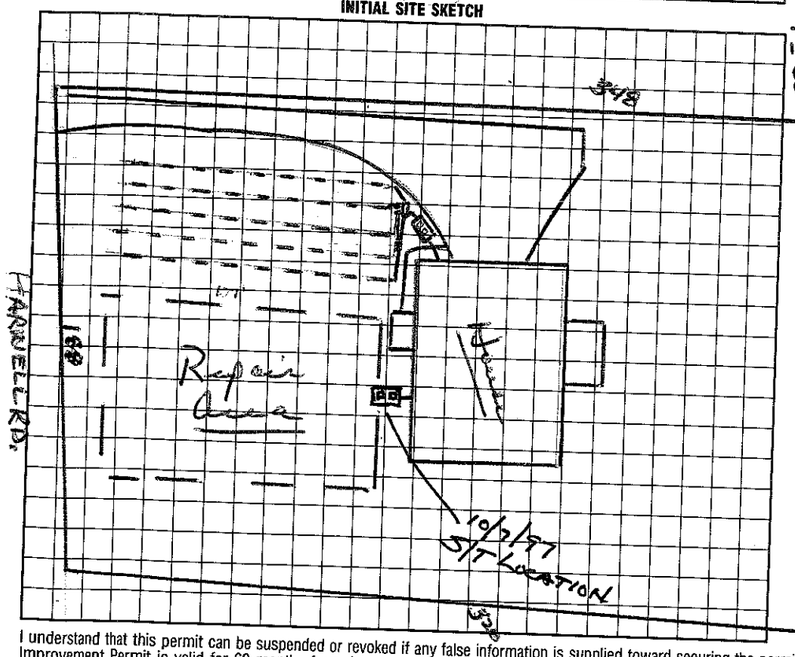

AS BUILT SKETCH

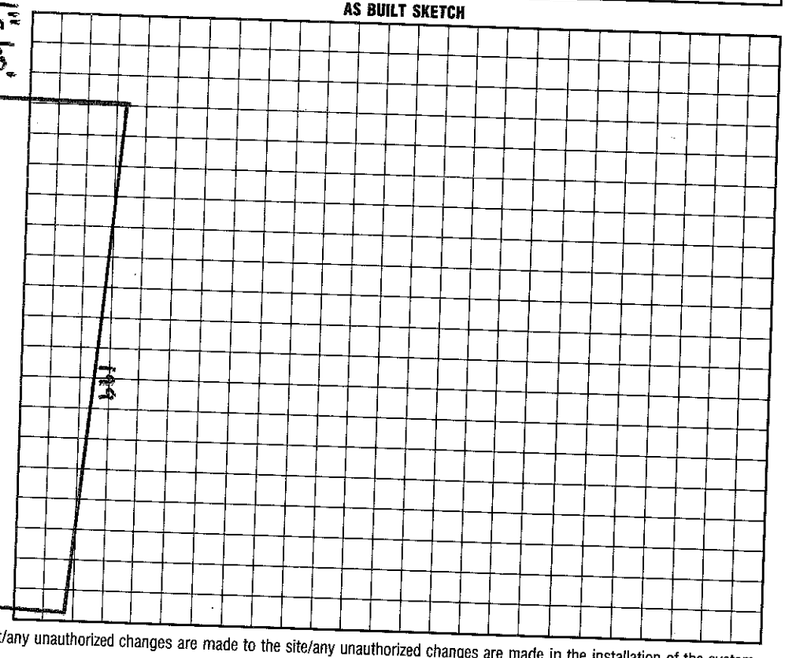

I understand that this permit can be suspended or revoked if any false information is supplied toward securing the permit/any unauthorized changes are made to the site/any unauthorized changes are made in the installation of the system. Improvement Permit is valid for 60 months from date of issuance.

Signed: *Angela Johnston

Improvement Permit by: Authorization to Construct Wesley Sparks RS. date 2/11/97

Existing System Inspection by: Wesley Sparks RS. date 2/11/97

Installed by: Larry Bean

Certificate of Completion by: Maria H. Dotson date 10/16/97

Operation Permit by: Maria H. Dotson date 10/16/97

HEALTH DEPT. COPY: WHITE INSPECTION COPY (FINAL): GREEN OWNER COPY (FINAL): YELLOW INSPECTION COPY (INITIAL): PINK OWNER COPY (INITIAL): GOLD