IREDELL COUNTY HEALTH DEPARTMENT

STATESVILLE 704-878-5305 MOORESVILLE 704-664-5281

IMPROVEMENT PERMIT / AUTHORIZATION TO CONSTRUCT / OPERATION PERMIT / EXISTING SYSTEM INSPECTION

PERMIT# 082845 PIN# 4645 38 7001

OWNER OR CONTRACTOR Keith Carroll PHONE: Business 873-5362 Home

ADDRESS 134 B Mueller Cr. DATE 7/29/99

LOCATION Williamson Rd. TR Alcove Rd. TR Templeton Rd. TL Harwell Rd. corner lot on (L)

SUBDIVISION QUEENS COVE BLOCK / SECTION 2 LOT 12A LOT AREA 1.38AC SITE CLASS RS DESIGN FLOW 360 L.T.A.R. .3

Septic Tank: 1000 Gallons; STB 794 Date 6/22/99

Pump Tank: Gallons; PT Date

Pump Make: Model Serial No.

Nitrification Field: No Fields 1 Square Feet 1200 Linear Feet 400

No Lines 4 Trench Width 36" Max Trench Bottom Depth 36" Gravel Depth 12"

[X] New System [ ] Repair System Type: I, (II), III, IV, V, VI

System Description: Gravity-Conventional

Repair System Description: New

Maintenance Agreement Required: [ ] Yes [X] No

[ ] Slab [X] Crawl Space [ ] Basement w/plumbing [ ] Basement wo/plumbing

[X] House/Mod. Home No. Bedrooms 3

[ ] Mobile Home No. Bathrooms 2

[ ] Business No. Employees


[ ] Other

Water Supply: [X] Individual [ ] Public [ ] Community


Comments:/Conditions:

Comments:/Conditions:

INITIAL SITE SKETCH

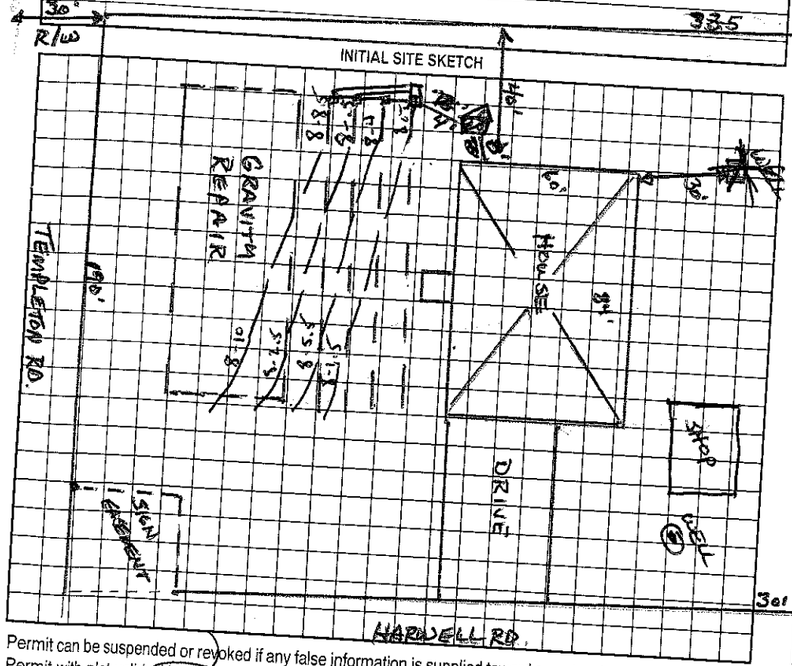

AS BUILT SKETCH

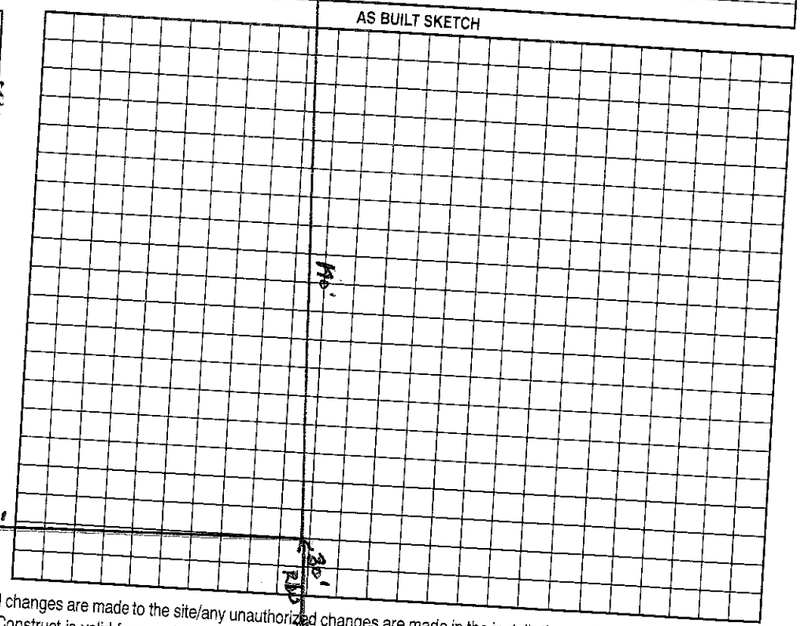

Permit can be suspended or revoked if any false information is supplied toward securing the permit/any unauthorized changes are made to the site/any unauthorized changes are made in the installation of the system. Improvement Permit with plat valid without expiration. Improvement Permit with site plan valid for sixty months. Authorization to Construct is valid for a period equal to that of Improvement Permit – not to exceed sixty months.

Signed: * date 8/3/99

Improvement Permit by: Wesley Sparks RS. date 7/29/99

Authorization to Construct by: Wesley Sparks RS. date 7/29/99

Installed by: FJ Erwin

Operation Permit by: Wesley Sparks RS. date 11/4/99

Existing System Inspection by: Wesley Sparks RS. date 11/4/99

HEALTH DEPT. COPY: WHITE OWNER COPY (FINAL): YELLOW OWNER COPY (INITIAL): PINK