IREDELL COUNTY HEALTH DEPARTMENT

STATESVILLE 704-878-5305 MOORESVILLE 704-664-5281

Authorization to Construct

IMPROVEMENT PERMIT / ~~CERTIFICATE OF COMPLETION~~ / OPERATION PERMIT / EXISTING SYSTEM INSPECTION

PROPERTY DESCRIPTION NO. 20030 DATE 4/9/96 TAX MAP NO. 2H A 17 pt of Watershed: ☐ Yes ☒ No

OWNER OR CONTRACTOR Christopher Anderson PHONE: Business 910-788-5759 Home 4645390634

ADDRESS 1009 Kingstree Ridge Dr. W-S NC 27127

LOCATION Templeton Rd TR Quail Ridge Dr. TL lot on (R) just before cul de sac

SUBDIVISION Templeton Place BLOCK / SECTION 1 LOT 14 LOT AREA .71 AC SITE CLASS. PS DESIGN FLOW 480 L.T.A.R. .35

Septic Tank: 1000 Gallons; STB 1012 Date 12/16/96
Pump Tank: ______ Gallons; PT ______ Date ______
Pump Make: ______ Model ______ Serial No. ______
Nitrification Field: No Fields 1 Square Feet 1371 Linear Feet (457) 230*
No Lines ~~4~~ 3 Trench Width 24" Max Trench Bottom Depth 30" Gravel Depth 6" SAND

☒ New System ☐ Repair System Type: I II (III) IV V VI
System Description: *16" Prefab Panel Blocks
Repair System Description: Same
Maintenance Agreement Required: ☐ Yes ☒ No


☒ House/Mod. Home ☐ Mobile Home ☐ Business ☐ Other
No. Bedrooms 4 No. Bathrooms 4 No. Employees ______
☐ Slab ☒ Crawl Space ☐ Basement w/plumbing ☐ Basement wo/plumbing

Water Supply: ☒ Individual ☐ Community ☐ Public


Comments: Gravity Panels - 1" = 30' scale dimensions are accurate - no changes without approval from ICHD.

Comments: 3 lines at 77-78 feet installed

INITIAL SITE SKETCH

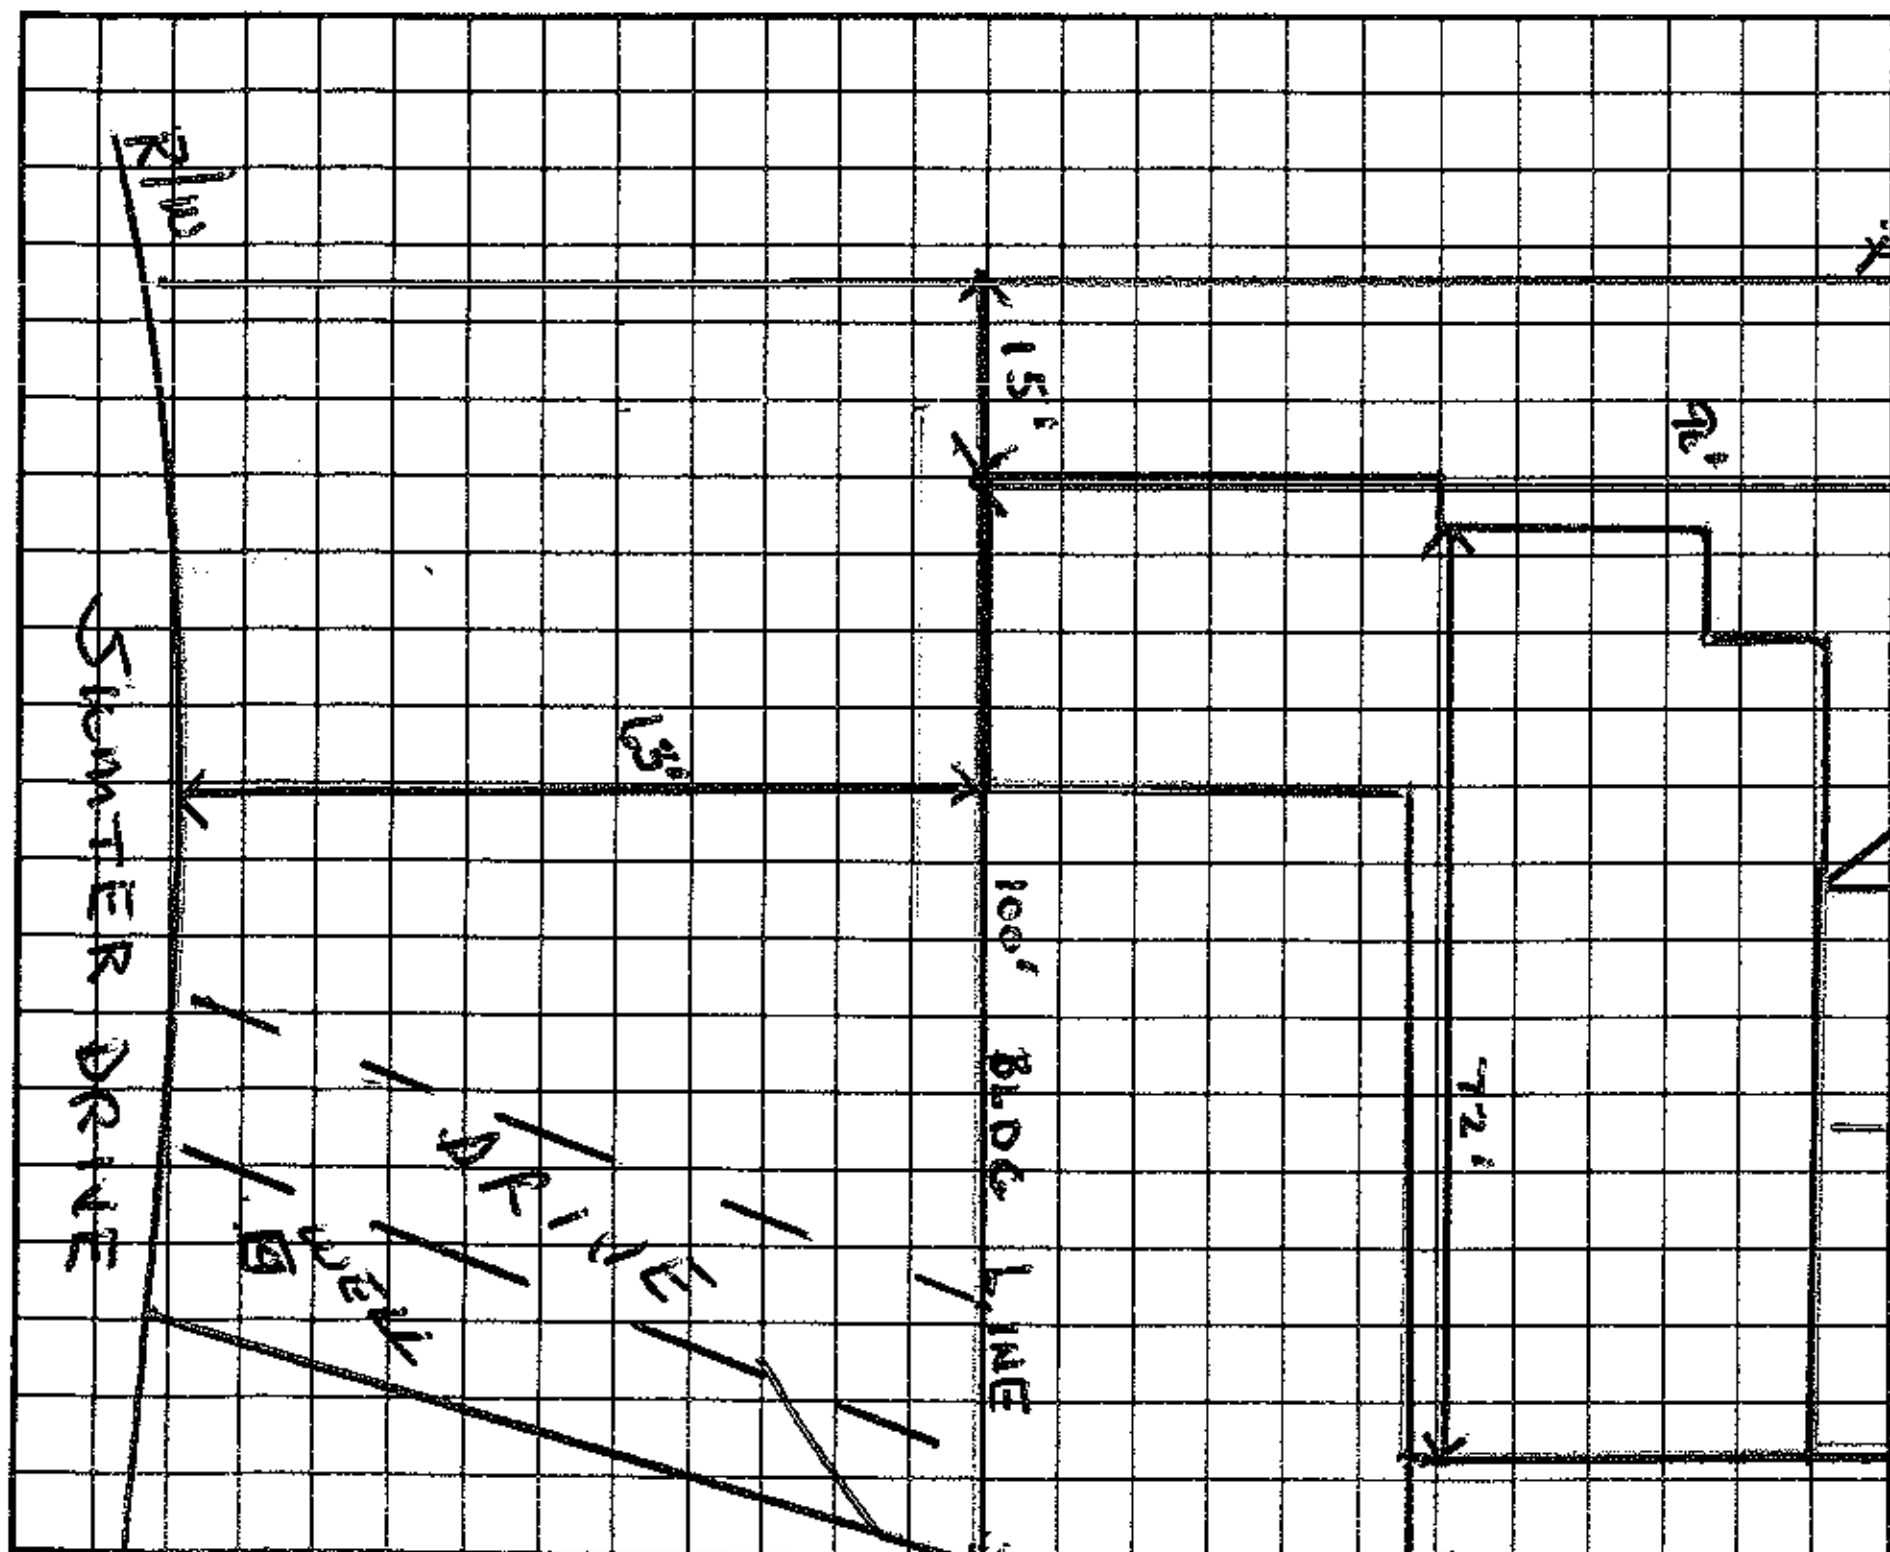

AS BUILT SKETCH

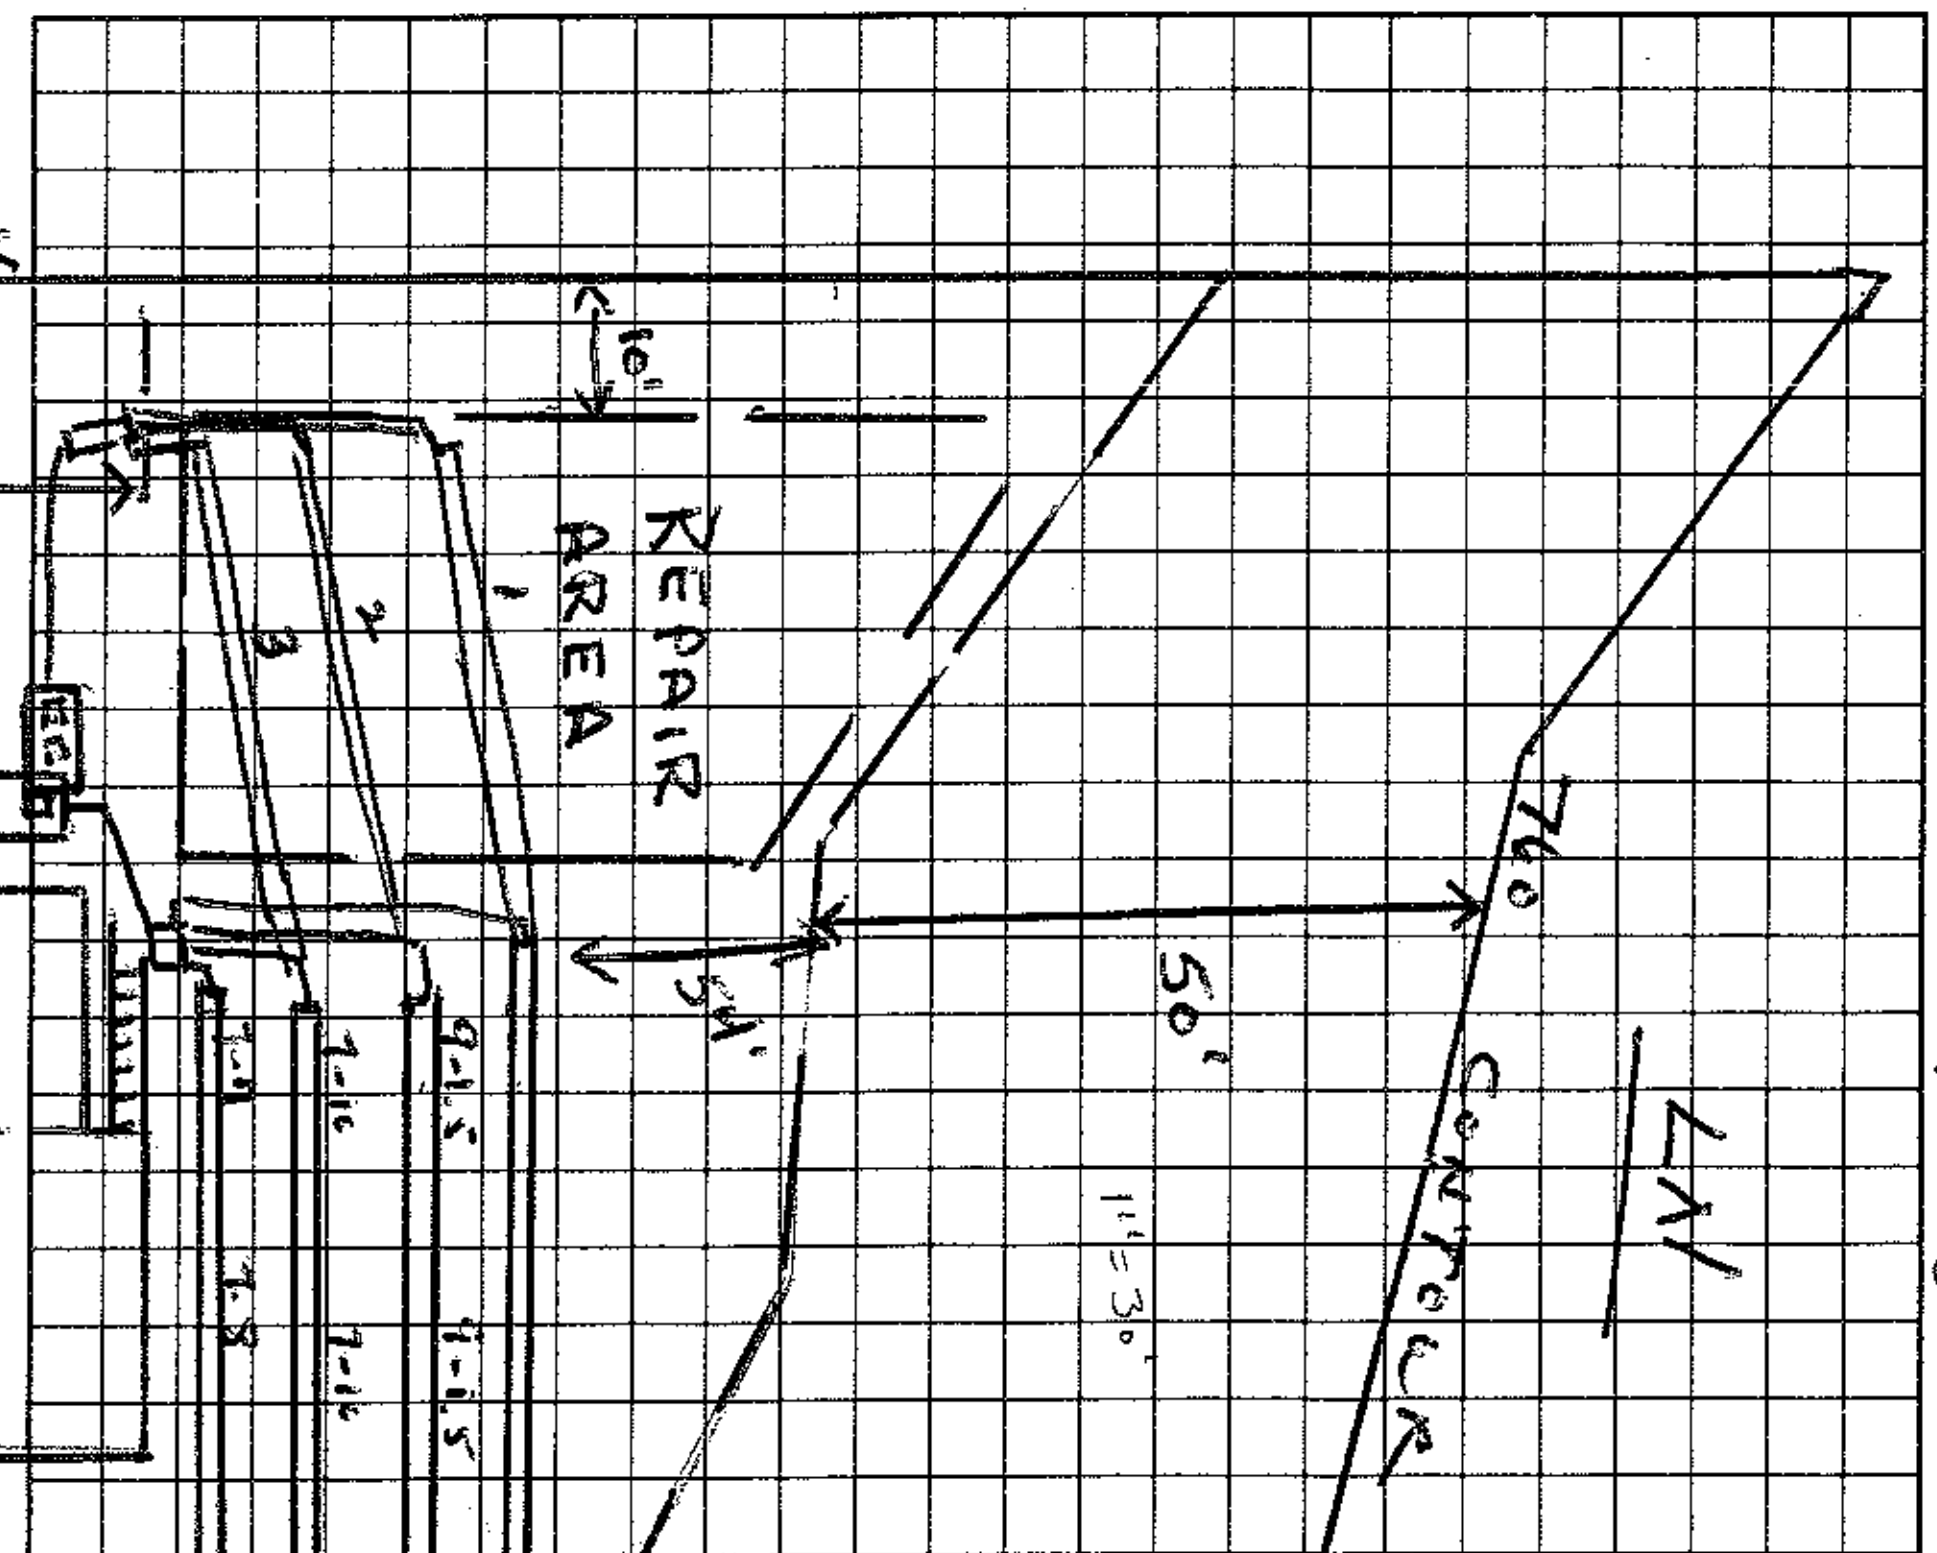

1" = 30'

I understand that this permit can be suspended or revoked if any false information is supplied toward securing the permit/any unauthorized changes are made to the site/any unauthorized changes are made in the installation of the system.

Authorization to Construct valid 5 years

Signed: Martha Anderson

Improvement Permit by: ______ date ______

Authorization to Construct ~~Existing System Inspection~~ by: Wesley Sparks RS date 4/9/96

Installed by: David Younts

A/E Certificate of Completion by: Wesley Sparks RS date 3/25/97

Operation Permit by: Wesley Sparks RS date 3/25/97

HEALTH DEPT. COPY: WHITE INSPECTION COPY (FINAL): GREEN OWNER COPY (FINAL): YELLOW INSPECTION COPY (INITIAL): PINK OWNER COPY (INITIAL): GOLD