IREDELL COUNTY HEALTH DEPARTMENT

Thoroughfare to Construct

STATESVILLE 704-878-5305 MOORESVILLE 704-664-5281

IMPROVEMENT PERMIT / ~~CERTIFICATE OF COMPLETION~~ / OPERATION PERMIT / EXISTING SYSTEM INSPECTION

PROPERTY DESCRIPTION NO. 21172 DATE 11/14/95 TAX MAP NO. 2H-A-17 Watershed: ☐ Yes ☒ No

OWNER OR CONTRACTOR Steve + Peggy Kovacsar PHONE: Business 875-0680 Home 4645 391 3607

ADDRESS 148 Royal Point Dr. Mooresville, NC. 28115

LOCATION Sumter Dr, Templeton TR on Quail Ridge (R) on Sumter Dr. on (L) at cul de sac

SUBDIVISION Templeton Est. BLOCK / SECTION II LOT 20 LOT AREA .62 SITE CLASS. PS DESIGN FLOW 480 L.T.A.R. .3

Septic Tank: 1000 Gallons; STB 794 Date 8/7/95

Pump Tank: _____ Gallons; PT _____ Date _____

Pump Make: _____ Model _____ Serial No. _____

Nitrification Field: No Fields 1 Square Feet 1600 Linear Feet 400 *

No Lines 5 Trench Width 36" Max Trench Bottom Depth 36" Gravel Depth 6" SAND

☒ New System ☐ Repair System Type: I, II, (III), IV, V, VI

System Description: GRAV. INFIL

Repair System Description: Pressure Panel

Maintenance Agreement Required: ☐ Yes ☒ No

☒ House/Mod. Home No. Bedrooms 4

☐ Mobile Home No. Bathrooms 3

☐ Business No. Employees ____

☐ Other _____


☐ Slab ☒ Crawl Space ☐ Basement w/plumbing ☐ Basement wo/plumbing

Water Supply: ☒ Individual ☐ Community ☐ Public


Comments: * 25% reduction for INFILTRATOR use 11/15/95 REISSUE Permit, change in contour plan change.

Comments: Gutter drains must be routed to drain over drainfield

INITIAL SITE SKETCH

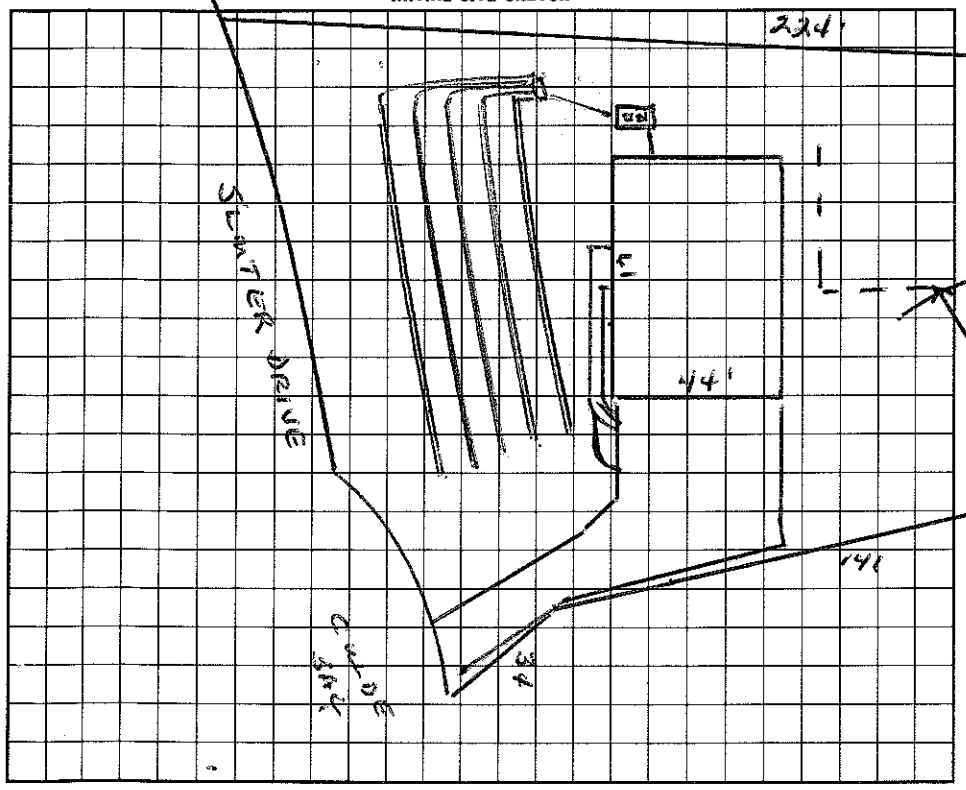

AS BUILT SKETCH

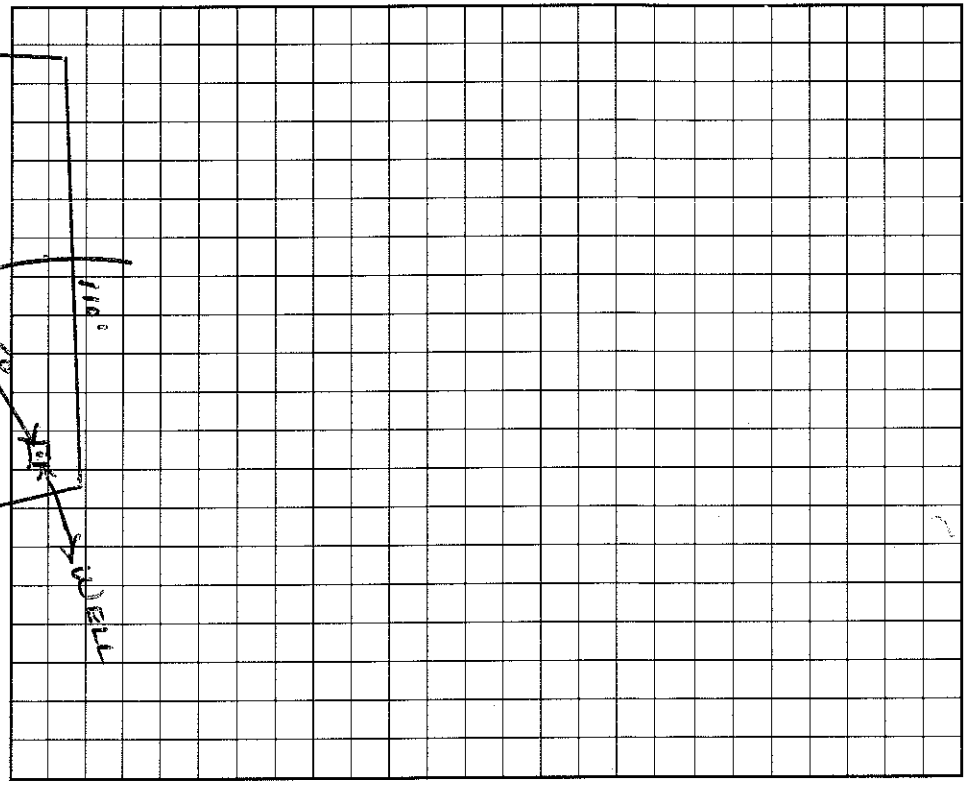

I understand that this permit can be suspended or revoked if any false information is supplied toward securing the permit/any unauthorized changes are made to the site/any unauthorized changes are made in the installation of the system.

Signed: _____

Improvement Permit by: _____ date _____

Existing System Inspection by: Thoroughfare to Construct: Wesley Sparks R.S. date 11/14/95

Installed by: Bobby Mayhew

Certificate of Completion by: Wesley Sparks R.S. date 12/5/95

Operation Permit by: Wesley Sparks R.S. date 12/5/95

HEALTH DEPT. COPY: WHITE INSPECTION COPY (FINAL): GREEN OWNER COPY (FINAL): YELLOW INSPECTION COPY (INITIAL): PINK OWNER COPY (INITIAL): GOLD