4645392377

IREDELL COUNTY HEALTH DEPARTMENT

STATESVILLE 704-878-5305 MOORESVILLE 704-664-5281

IMPROVEMENT PERMIT / CERTIFICATE OF COMPLETION / OPERATION PERMIT / EXISTING SYSTEM INSPECTION

PROPERTY DESCRIPTION NO. 21975 DATE Sept 13, '95 TAX MAP NO. part of 2 #A17 Watershed: ☑ Yes ☐ No

OWNER OR CONTRACTOR Robert E. Jacks / Genesis Homes PHONE: Business _____ Home _____ WS4

ADDRESS PO Box 5000-269, Mooresville

LOCATION Alcove Rd. TR, Templeton TR Quail Ridge TL Sumter 3rd on left

SUBDIVISION Templeton Est. BLOCK / SECTION _____ LOT 21 LOT AREA 1.69 Ac SITE CLASS. PS on 1956 DESIGN FLOW 360 gpd L.T.A.R. .03

Septic Tank: 1000 Gallons; STB 794 Date 1/12/96

Pump Tank: _____ Gallons; PT _____ Date _____

Pump Make: _____ Model _____ Serial No. _____

Nitrification Field: No Fields 1 Square Feet 900 Linear Feet 300

No Lines 4@75' Trench Width 36" Max Trench Bottom Depth 36" Gravel Depth NA

☑ New System ☐ Repair System Type: I, II, III, IV, V, VI

System Description: Gravity Infiltrator

Repair System Description: Pumped Infiltrator

Maintenance Agreement Required: ☐ Yes ☑ No

☑ House/Mod. Home ☐ Mobile Home ☐ Business ☐ Other

No. Bedrooms 3 No. Bathrooms 2 No. Employees ____


☐ Slab ☑ Crawl Space ☐ Basement w/plumbing ☐ Basement wo/plumbing

Water Supply: ☐ Individual ☐ Community ☐ Public

Comments: Backfill approx 1 foot at rear of house where graded/cut for foundation. Raise plumbing accordingly in order to avoid use of pump.

Comments:

INITIAL SITE SKETCH

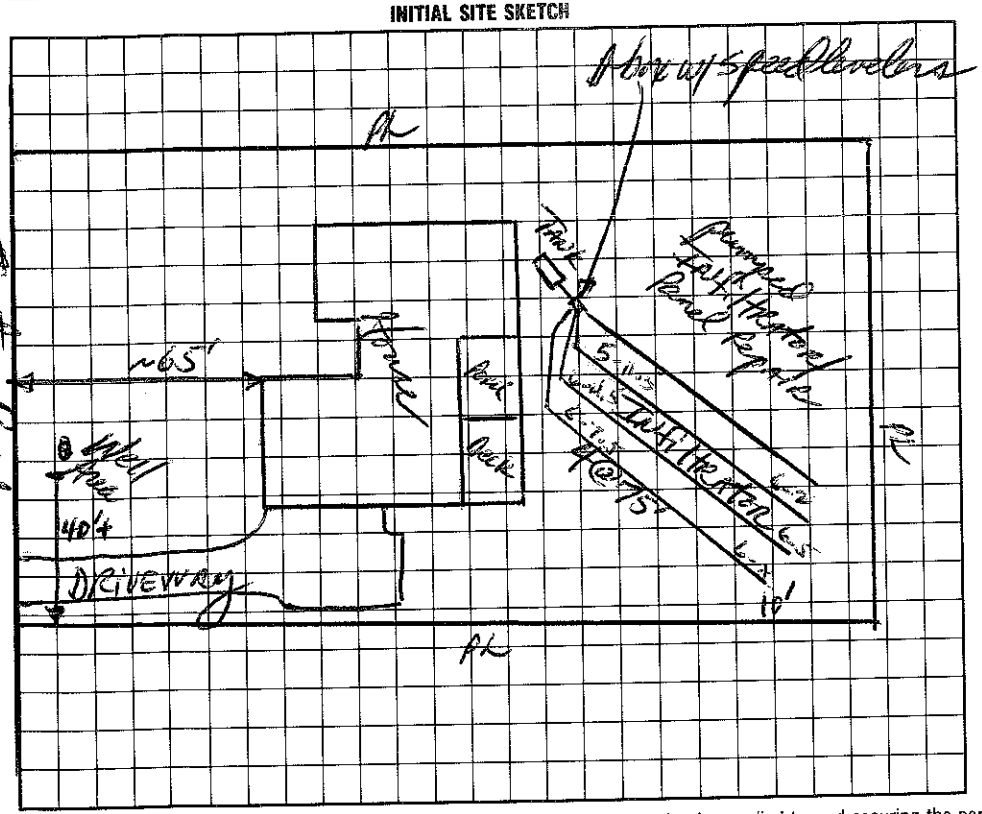

AS BUILT SKETCH

I understand that this permit can be suspended or revoked if any false information is supplied toward securing the permit/any unauthorized changes are made to the site/any unauthorized changes are made in the installation of the system.

Signed: Robert E. Jacks Jr

Improvement Permit by: [signature] RS date 9-13-95

Existing System Inspection by: _____ date _____

Installed by: F J Ennis

Certificate of Completion by: Wesley Sparks RS date 2/25/96

Operation Permit by: Wesley Sparks RS date 2/25/96

HEALTH DEPT. COPY: WHITE INSPECTION COPY (FINAL): GREEN OWNER COPY (FINAL): YELLOW INSPECTION COPY (INITIAL): PINK OWNER COPY (INITIAL): GOLD