IREDELL COUNTY HEALTH DEPARTMENT

STATESVILLE 704-878-5305 MOORESVILLE 704-664-5281

IMPROVEMENT PERMIT / AUTHORIZATION TO CONSTRUCT / OPERATION PERMIT / EXISTING SYSTEM INSPECTION

PERMIT# 070636 PIN# 4645393396 DATE 3/25/2000

OWNER OR CONTRACTOR Karen & Richard Hutchinson PHONE: Business 201-0030 Rick Home 664-1320

ADDRESS 266 Camino Real Mooresville NC

LOCATION Alcove TR Templeton TR Quail TL Sumter 2nd on left

SUBDIVISION Templeton Est BLOCK / SECTION 2 LOT 22 LOT AREA .63 Acre SITE CLASS. PS DESIGN FLOW 450 gpd T.A.R. .3

Septic Tank: 1000 Gallons; STB 1012 Date 7-9-2000
Pump Tank: 1000 Gallons; PT 1117 Date 5-3-2000
Pump Make: Gould's Model WEC 311H Serial No.
Nitrification Field: No Fields 1 Square Feet 1200' Linear Feet 400'
No Lines 5 at 80' Trench Width 36" Max Trench Bottom Depth 36" Gravel Depth N/A

☐ New System ☐ Repair System Type: I, II, III, IV, V, VI
System Description: Pumped IAW 25% Reduction
Repair System Description: Pump-Panel Blk
Maintenance Agreement Required: ☐ Yes ☐ No

☒ House/Mod. Home ☐ Mobile Home ☐ Business ☐ Other
No. Bedrooms 4 No. Bathrooms 3.5 No. Employees


☐ Slab ☒ Crawl Space ☐ Basement w/plumbing ☐ Basement wo/plumbing


Water Supply: ☒ Individual ☐ Public ☐ Community

Comments:/Conditions: Keep well at least 50' From any part of Septic System.

Comments:/Conditions: Replaced permit issued 12/15/97
Now a pumped system
20' variance to Sprinkler Creek
Filter & riser installed
Checked tanks & AS BUILT SKETCH 8/30/00 MD

INITIAL SITE SKETCH Scale 1:50

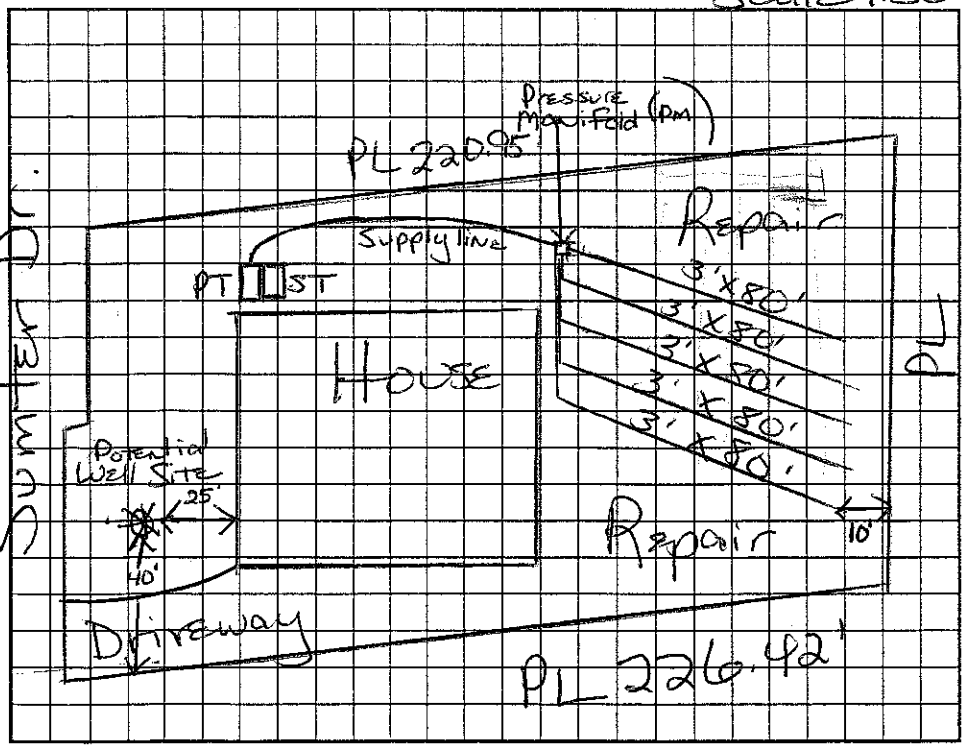

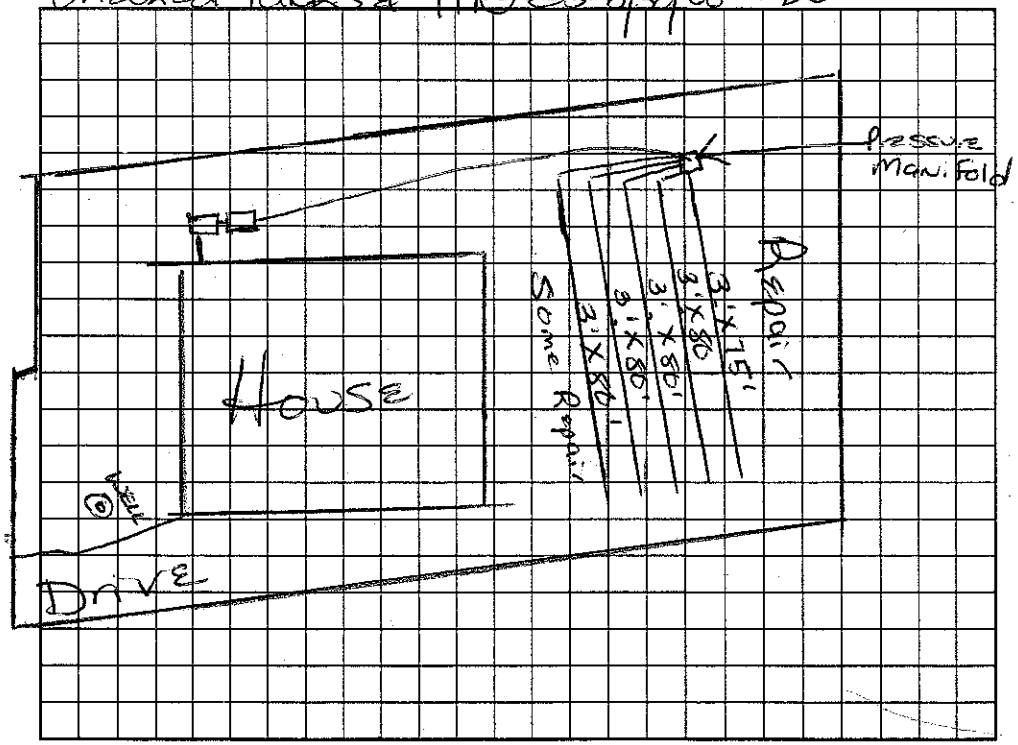

Permit can be suspended or revoked if any false information is supplied toward securing the permit/any unauthorized changes are made to the site/any unauthorized changes are made in the installation of the system. Improvement Permit with plat valid without expiration. Improvement Permit with site plan valid for sixty months. Authorization to Construct is valid for a period equal to that of Improvement Permit – not to exceed sixty months.

Signed: Richard T. Hutchinson date 4-28-00 Installed by: Forrest Shuford

Improvement Permit by: Maria H. Colson R.S. date 3/27/2000 Operation Permit by: Wesley Sparks R.S. date 9/28/00

Authorization to Construct by: Maria H. Colson R.S. date 3/27/2000 Existing System Inspection by: date

HEALTH DEPT. COPY: WHITE OWNER COPY (FINAL): YELLOW OWNER COPY (INITIAL): PINK