IREDELL COUNTY HEALTH DEPARTMENT

STATESVILLE 704-878-5305 MOORESVILLE 704-664-5281

IMPROVEMENT PERMIT / AUTHORIZATION TO CONSTRUCT / OPERATION PERMIT / EXISTING SYSTEM INSPECTION

PERMIT # REPAIR PIN # 4645 44 4577 DATE 9/24/09

OWNER or APPLICANT JAMES JIMMONS PHONE: Business 704-892-0066 Home: [redacted]

OWNER or APPLICANT ADDRESS 195 BESFORD RD. MOORESVILLE, NC. 28117

LOCATION / DIRECTIONS ALCOVERA STR BESFORD RD L FORK TO LAST PROPERTY ON L

SUBDIVISION No BLOCK / SECTION LOT # LOT AREA ~1.29AC DESIGN FLOW 360 L.T.A.R. .125

Septic Tank 1000 Gallons: STB Date

Pump Tank Gallons: P T Date

Pump Make Model Serial #

Nitrification Field No Fields 1 No Lines 3 Linear Feet 300

Trench Width 3' Max. Trench Bottom Depth 30" Gravel Depth No GRAVITY PRESSURE

☐ New System ☒ Repair ☐ Expansion System Type I II III IV V VI

System Description:

Repair System Description: BR - 25% REDUCTION

Maintenance Agreement Required ☐ YES ☒ NO

☒ Residence No. Bedrooms 3 ☐ Business No. Persons ☐ Other No. Employees ☐ Slab ☐ Crawl Space ☒ Basement w/plumbing ☐ Basement w/o plumbing


Water Supply ☒ Private ☐ Public ☐ Community

Comments / Conditions SHALLOW 30" TRENCH DEPTH.

Comments / Conditions

Note leaf on down spout for 25% Reduction

INITIAL SITE SKETCH

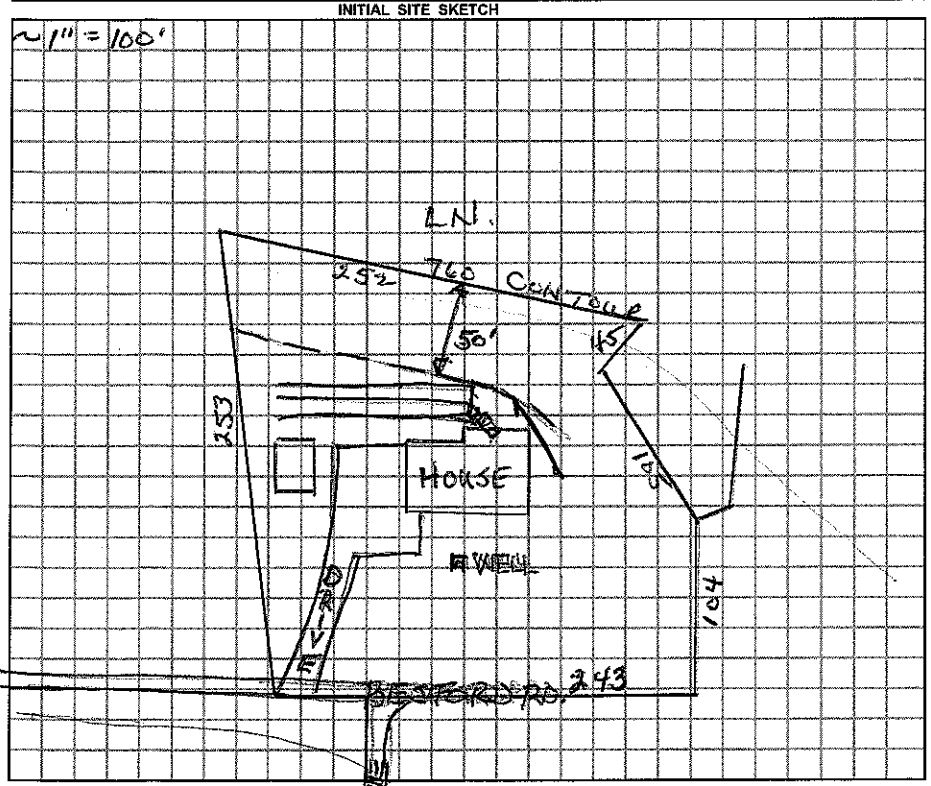

AS BUILT SKETCH

Permit can be suspended or revoked if any false information is supplied toward securing the permit / any unauthorized changes are made to the site / any unauthorized changes are made in the installation of the system.

☐ *IMPROVEMENT PERMIT w / plat valid without expiration* ☐ *IMPROVEMENT PERMIT w / site plan valid for 60 mos.* ☒ *AUTHORIZATION TO CONSTRUCT valid for period equal to IMPROVEMENT PERMIT-not to exceed 60 mo.*

Owner / Applicant Signature: John Simmons Date 9-22-09

Improvement Permit by: Wesley Sparks RS. Date 9/24/09

Authorization to Construct by: Wesley Sparks RS Date 9/24/09

YOU SHOULD CONTACT A LOCATOR SERVICE PRIOR TO ANY EXCAVATION.

Installed by: Rowan Septic Tank

Operation Permit by: Wesley Sparks RS. Date: 9/30/09

Existing System Inspected by: Date:

WHITE COPY Environmental Health YELLOW COPY (Final) Owner / Applicant PINK COPY (Initial) Owner / Applicant