IREDELL COUNTY HEALTH DEPARTMENT

STATESVILLE 704-878-5305 MOORESVILLE 704-664-5281

IMPROVEMENT PERMIT / CERTIFICATE OF COMPLETION / OPERATION PERMIT / EXISTING SYSTEM INSPECTION

PROPERTY DESCRIPTION NO. 16400 DATE June 15, '93 TAX MAP NO. 2H-18-A6

OWNER OR CONTRACTOR Craig Rosemon PHONE: Business 896-0723 Home 4645 44 7793

ADDRESS 19710 Gruenler Pt. Huntersville, NC

LOCATION Alcove Rd. To Webb Cby at end

SUBDIVISION Shady Grove BLOCK / SECTION ___ LOT 6 LOT AREA 40,000 Sq ft SITE CLASS. PS L.T.A.R. .3

Water Supply: ☒ Individual ☐ Community ☐ Public

Septic Tank: ~~1250~~ 1000 Gallons; STB ~~375~~ ACP Date 11-18-93 Goulds WE05111 HH SN2698275

Pump Tank: ~~1250~~ 1000 Gallons; PT 1203 ACP Date 7-13-93

Nitrification Field: No Fields ___ Square Feet 1200 Linear Feet 400

No Lines 4 Trench Width 36" Trench Depth 24" Gravel Depth 12"

☒ New System ☐ Repair System Type: I, II, III, IV, V, VI

System Description: pumped conventional

Repair System Description: LP-Panel

Maintenance Agreement Required: ☐ Yes ☒ No

☒ House/Mod. Home ☐ Mobile Home ☐ Business ☐ Other

No. Bedrooms 3 No. Bathrooms 2½ No. Employees ___

Garbage Disposal: ☒ Yes ☐ No

Auto. Dishwasher: ☒ Yes ☐ No


Auto. Washing Machine: ☒ Yes ☐ No

Other ___


☐ Slab ☒ Crawl Space ☐ Basement w/plumbing ☐ Basement wo/plumbing

Comments: Dose 200 gal per 7 min cycle; follow contour. Keep trenches shallow 11-19-93 OKed use of 1000 gal. tanks

INITIAL SITE SKETCH

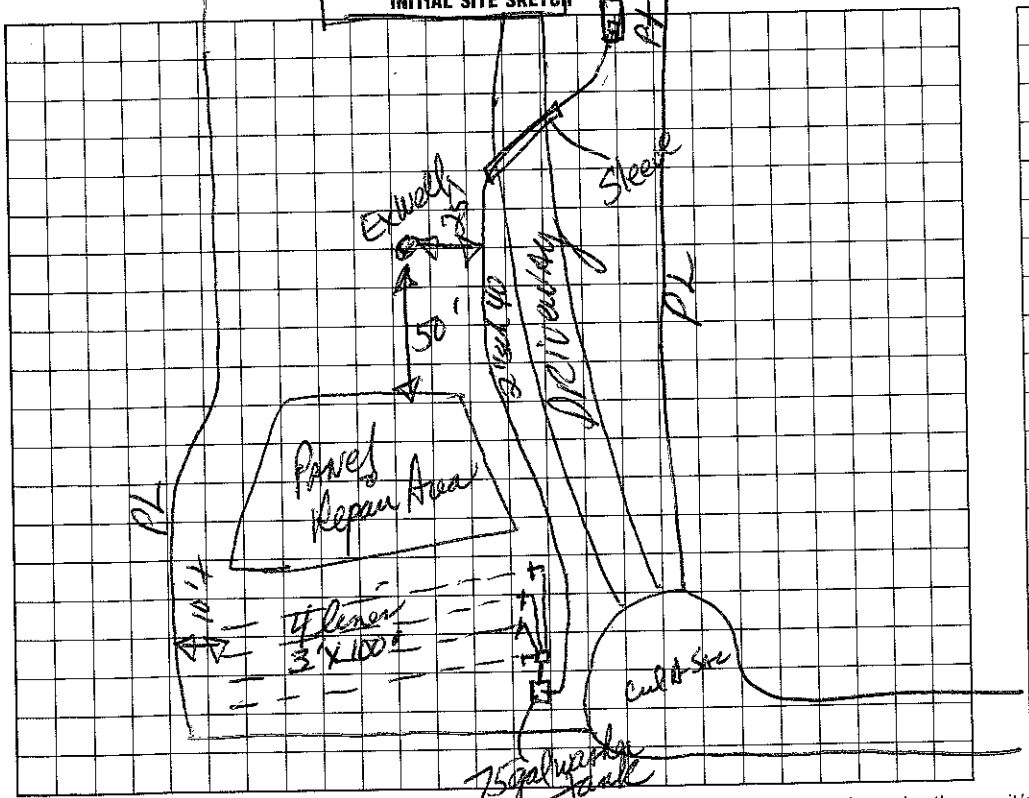

AS BUILT SKETCH

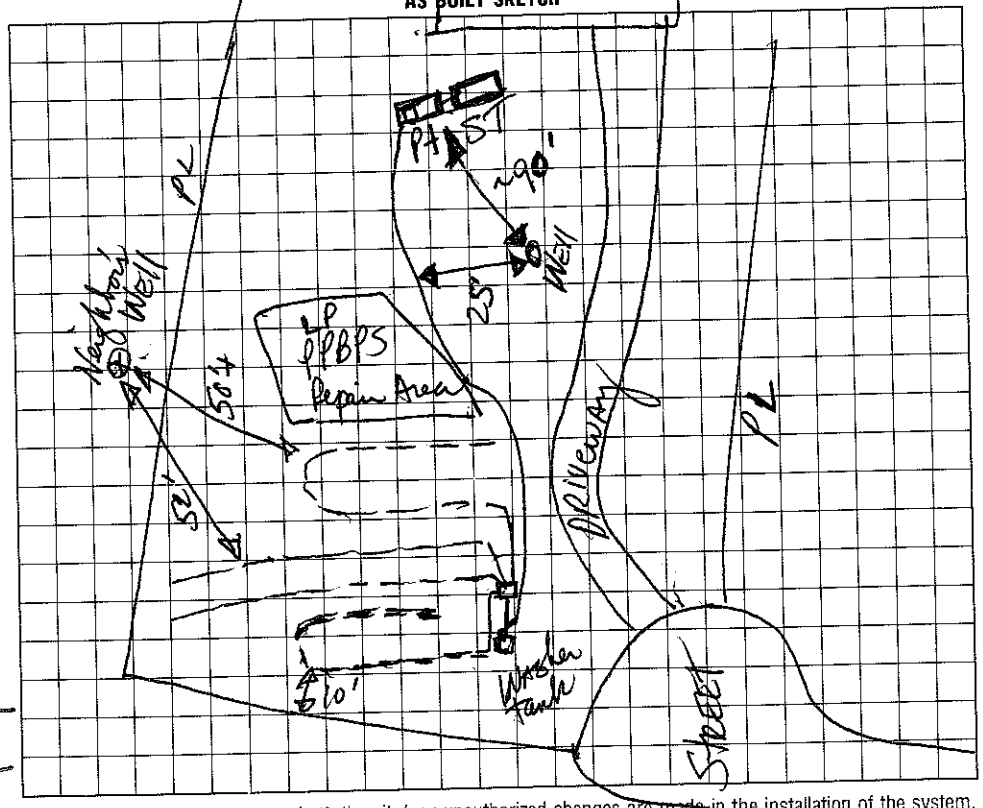

I understand that this permit can be suspended or revoked if any false information is supplied toward securing the permit/any unauthorized changes are made to the site/any unauthorized changes are made in the installation of the system. Improvement Permit is valid for 60 months from date of issuance.

Signed: X Little Hawkins

Improvement Permit by: David R. Hinson, RS date 6/15/93

Existing System Inspection by: ___ date ___

Installed by: Little Hawkins

Certificate of Completion by: ___ date ___

Operation Permit by: David R. Hinson, RS date 12/2/93

HEALTH DEPT. COPY: WHITE INSPECTION COPY (FINAL): GREEN OWNER COPY (FINAL): YELLOW INSPECTION COPY (INITIAL): PINK OWNER COPY (INITIAL): GOLD