IREDELL COUNTY HEALTH DEPARTMENT

STATESVILLE 704-878-5305 MOORESVILLE 704-664-5281

IMPROVEMENT PERMIT / CERTIFICATE OF COMPLETION / OPERATION PERMIT / EXISTING SYSTEM INSPECTION

PROPERTY DESCRIPTION NO. 1789 DATE March 10, '94 TAX MAP NO. 2H 11 66

OWNER OR CONTRACTOR Jeffrey & Dawn Fenske PHONE: Business _____ Home 663-7383 C.N. Watershed: ☑ Yes ☐ No

ADDRESS 539 Oak St. Mooresville 4645-46-0364

LOCATION 1296 (Alone) TR 1108 TL Hallwell Drive ~6th on left

SUBDIVISION Queens Cove BLOCK / SECTION 2 LOT 6 LOT AREA 3.93Ac SITE CLASS. P3 DESIGN FLOW 480gpd L.T.A.R. 0.3

Septic Tank: 1000 Gallons; STB 794 Delling Date 5-2-94

Pump Tank: _____ Gallons; PT _____ Date _____

Pump Make: _____ Model _____ Serial No. _____

Nitrification Field: No Fields 1 Square Feet 1620 Linear Feet 540

No Lines 5 Trench Width 36" Max Trench Bottom Depth 36"

☑ New System ☐ Repair System Type: I, (II), III, IV, V, Vh

System Description: gravity Conventional

Repair System Description: Same

Maintenance Agreement Required: ☐ Yes ☑ No

Gravel Depth _____ ☐ Slab ☑ Crawl Space ☐ Basement w/plumbing ☐ Basement wo/plumbing

☑ House/Mod. Home No. Bedrooms 4

☐ Mobile Home No. Bathrooms 2½

☐ Business No. Employees _____


☐ Other _____

Water Supply: ☑ Individual ☐ Community ☐ Public


Comments: 7/8/94 change to system layout approved Tank to be at rear of house w/ laterals going in direction of left side prop. line JPOT

Comments:

INITIAL SITE SKETCH

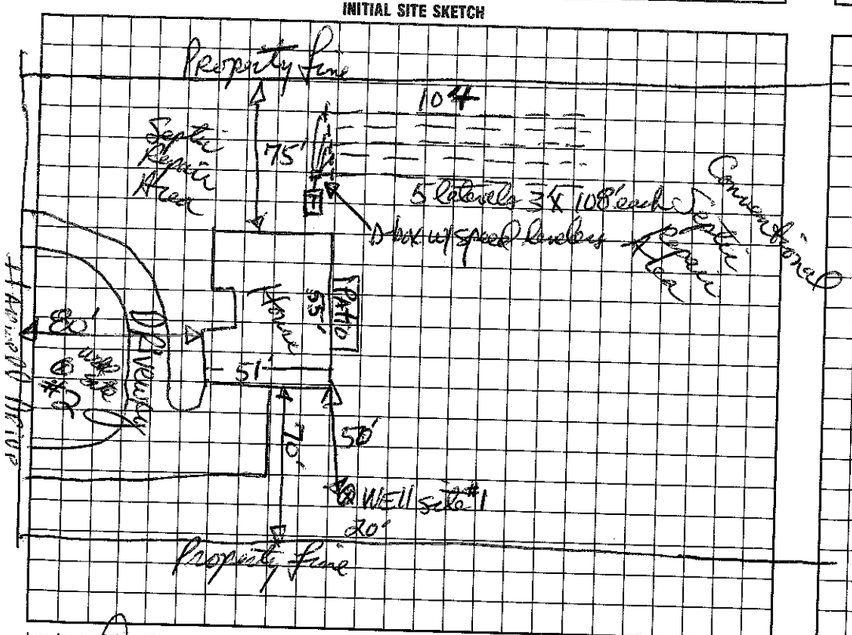

AS BUILT SKETCH

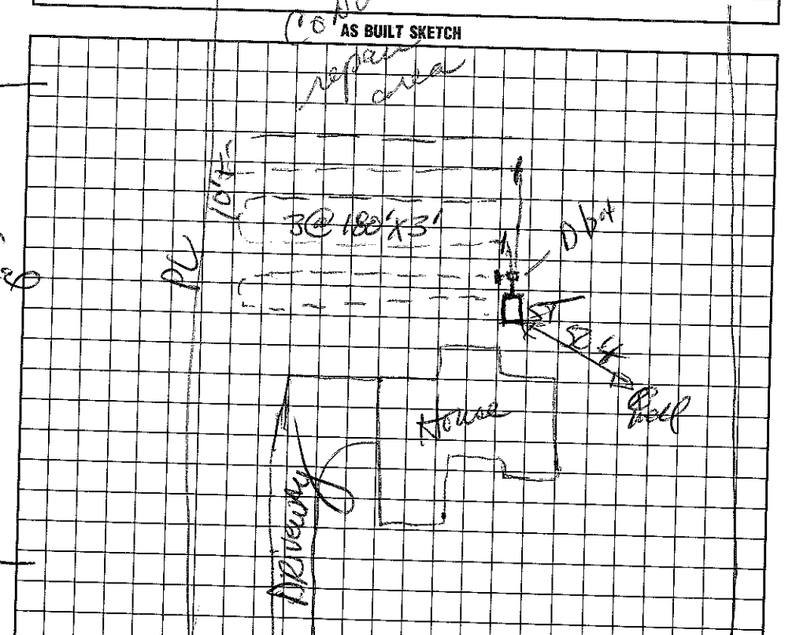

I understand that this permit can be suspended or revoked if any false information is supplied toward securing the permit/any unauthorized changes are made to the site/any unauthorized changes are made in the installation of the system. Improvement Permit is valid for 60 months from date of issuance.

Signed: X _____

Improvement Permit by: Darrell Hanson, RS date 3/10/94

Existing System Inspection by: _____ date _____

Installed by: Danny Hanson

Certificate of Completion by: Darrell Hanson, RS date 7/13/94

Operation Permit by: _____ date _____

HEALTH DEPT. COPY: WHITE INSPECTION COPY (FINAL): GREEN OWNER COPY (FINAL): YELLOW INSPECTION COPY (INITIAL): PINK OWNER COPY (INITIAL): GOLD