IREDELL COUNTY HEALTH DEPARTMENT

STATESVILLE 704-878-5305 MOORESVILLE 704-664-5281

IMPROVEMENT PERMIT / CERTIFICATE OF COMPLETION / OPERATION PERMIT / EXISTING SYSTEM INSPECTION

PROPERTY DESCRIPTION NO. 19059 DATE Nov. 18 '94 TAX MAP NO. 2H11 B10

OWNER OR CONTRACTOR Kam Chuen (Steve) Tong PHONE: Business _____ Watershed: ☑ Yes ☐ No LN

ADDRESS 760 Pinewood Circle Mooresville Home _____

LOCATION 1206 (Alcove) TR 1108 (Templeton) TL Harwell Dr. 2nd on left 4645-47-0198

SUBDIVISION Queens Cove BLOCK / SECTION 2 LOT 10 LOT AREA ~4AC SITE CLASS. PS DESIGN FLOW 600gpd L.T.A.R. .25-.3

Septic Tank: 1500 Gallons; STB 797 Ditch Witch Date 7-14-95

Pump Tank: _____ Gallons; PT _____ Date _____

Pump Make: _____ Model _____ Serial No. _____

Nitrification Field: No Fields 2 Square Feet 2100 Linear Feet 700

No Lines 4+3 Trench Width 36" Max Trench Bottom Depth 30" Gravel Depth 12"

☑ New System ☐ Repair System Type: I, II, III, IV, V, VI

System Description: gravity conventional

Repair System Description: same

Maintenance Agreement Required: ☐ Yes ☑ No

☐ Slab ☑ Crawl Space ☐ Basement w/plumbing ☑ Basement w/o plumbing partial

☑ House/Mod. Home No. Bedrooms 5

☐ Mobile Home No. Bathrooms 3 ½

☐ Business No. Employees ____


☐ Other _____

Water Supply: ☑ Individual ☐ Community ☐ Public


Comments: Follow contour with laterals ~350' per subfield

Comments: Installed substantially as shown. Divert storm water drainage around lower side of septic system.

INITIAL SITE SKETCH

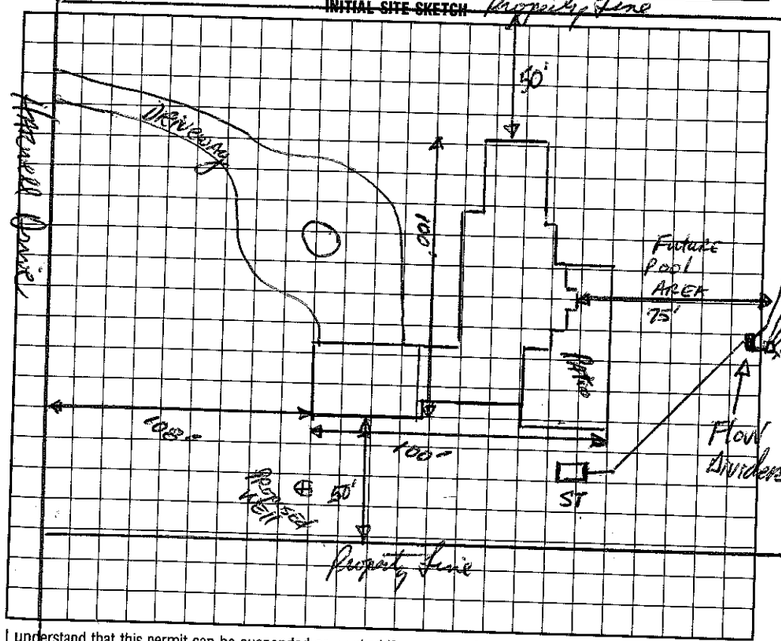

AS-BUILT SKETCH

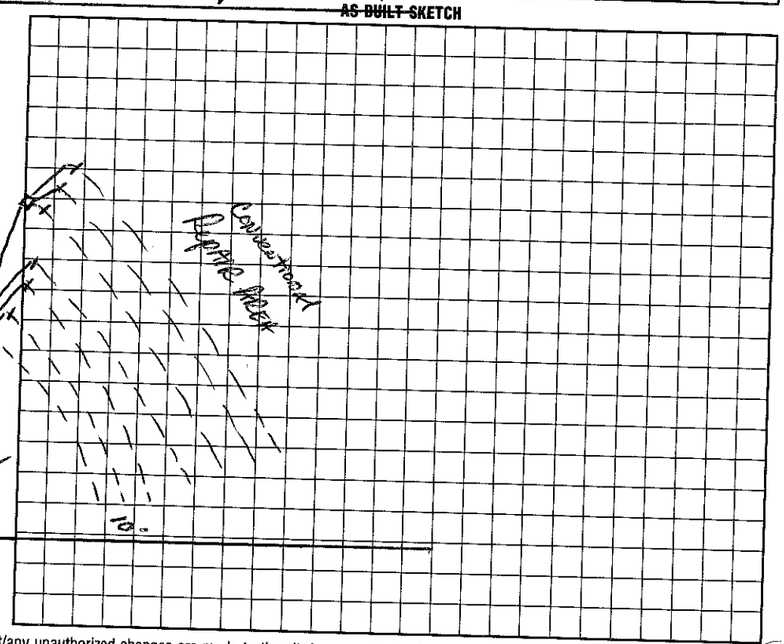

I understand that this permit can be suspended or revoked if any false information is supplied toward securing the permit/any unauthorized changes are made to the site/any unauthorized changes are made in the installation of the system. Improvement Permit is valid for 60 months from date of issuance.

Signed: _____

Improvement Permit by: Jackie R Hinson IRS date 11/18/94

Existing System Inspection by: _____ date _____

Installed by: Osborn

Certificate of Completion by: _____

Operation Permit by: Jackie R Hinson IRS date 10-3-95

HEALTH DEPT. COPY: WHITE INSPECTION COPY (FINAL): GREEN OWNER COPY (FINAL): YELLOW INSPECTION COPY (INITIAL): PINK OWNER COPY (INITIAL): GOLD