IREDELL COUNTY HEALTH DEPARTMENT

STATESVILLE 704-878-5305 MOORESVILLE 704-664-5281

IMPROVEMENT PERMIT / AUTHORIZATION TO CONSTRUCT / OPERATION PERMIT / EXISTING SYSTEM INSPECTION

$50 ck

PERMIT# 109851 PIN# 4645 59 2250 4645-48-1838 DATE 1-24-2003

OWNER OR CONTRACTOR St. Lawrence Homes (Dienst Ent) PHONE: Business (704) 892-7700 Home

ADDRESS 7930 W. Kenton Circle, Huntersville, NC 28078

LOCATION US 215 TL Alcove TR Templeton TR Templeton Bay TL Greenfield 1st end on left.

SUBDIVISION Templeton Bay BLOCK / SECTION LOT 12 LOT AREA 40,087 ft² SITE CLASS. PS DESIGN FLOW 480 gpd L.T.A.R. .3

Septic Tank: 1000 Gallons; STB 794 Date 10/30/02

Pump Tank: 1000 Gallons; PT 283 Date 12/17/02

Pump Make: Myers Model M520 Serial No.

Nitrification Field: No Fields 1 Square Feet 1215' Linear Feet 405'

No Lines 3@135' Trench Width 36" Max Trench Bottom Depth 36" Gravel Depth N/A

☒ New System ☐ Repair System Type: I, II, III, IV, V, VI

System Description: Pump-pm-25% Reduction

Repair System Description: Pump - Innovative

Maintenance Agreement Required: ☐ Yes ☒ No

☒ House/Mod. Home ☐ Mobile Home ☐ Business ☐ Other

No. Bedrooms 4 No. Bathrooms 4 No. Employees

☐ Slab ☒ Crawl Space ☐ Basement w/plumbing ☐ Basement wo/plumbing

Water Supply: ☐ Individual ☒ Public ☒ Community

Comments/Conditions: Per original permit - Do not cut house site. Backfill against foundation to provide drainage. Remove old burns in Septic system area.

Comments/Conditions: Keep Septic System at least 10' From PL.


Note: Builder requested change in Drainfield from Conventional to 25% Reduction

Checked tanks & lines MS

Installed EZ Flow Drain lines as Drawn

Scale 1:50

INITIAL SITE SKETCH

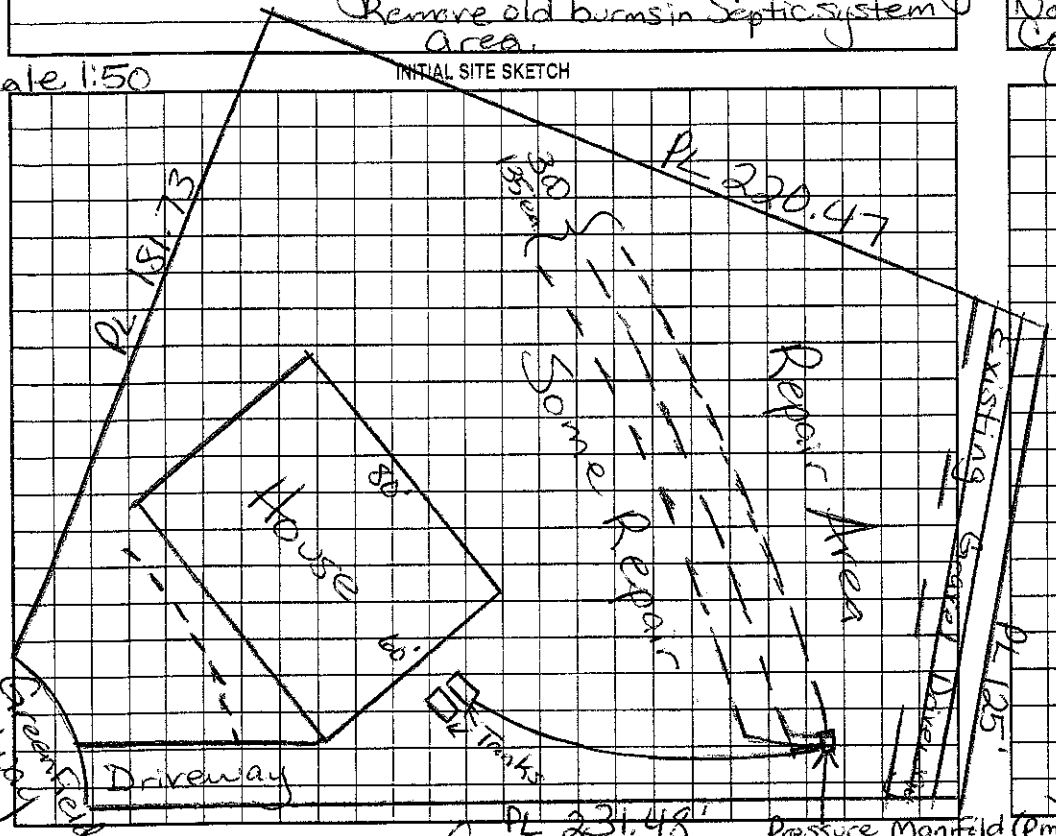

AS BUILT SKETCH

Permit can be suspended or revoked if any false information is supplied toward securing the permit/any unauthorized changes are made to the site/any unauthorized changes are made in the installation of the system. Improvement Permit with plat valid without expiration. Improvement Permit with site plan valid for sixty months. Authorization to Construct is valid for a period equal to that of Improvement Permit – not to exceed sixty months.

Signed: B Kunz date

Improvement Permit by: Maria H. Dotson RS date 1/24/03

Authorization to Construct by: Maria H. Dotson RS date 1/24/03

Installed by: BH RS

Operation Permit by: Maria H. Dotson RS date 2/7/03

Existing System Inspection by: date

HEALTH DEPT. COPY: WHITE OWNER COPY (FINAL): YELLOW OWNER COPY (INITIAL): PINK