IREDELL COUNTY HEALTH DEPARTMENT

STATESVILLE 704-878-5305 MOORESVILLE 704-664-5281

250.00 Paid

IMPROVEMENT PERMIT / AUTHORIZATION TO CONSTRUCT / OPERATION PERMIT / EXISTING SYSTEM INSPECTION

PERMIT# 133031 PIN# 4645482151 DATE 1-6-06

OWNER OR APPLICANT Tim Gibson PHONE: Business 875-4337 Home 664-1012 Cell 662-4773

ADDRESS 253 Templeton Rd Mooresville NC 28117

LOCATION Alcove Rd TR Templeton 4th house on left past Templeton Bay behind #249

SUBDIVISION ____ BLOCK / SECTION ____ LOT ____ LOT AREA .896 Acre SITE CLASS. PS DESIGN FLOW 480gpd L.T.A.R. .3

Septic Tank: 1000 Gallons: STB 1794 Date 11-21-05

Pump Tank: ____ Gallons: PT ____ Date ____

Pump Make: ____ Model ____ Serial No. ____

Nitrification Field: No Fields 1 Square Feet 400 Linear Feet 400'

No Lines 4@100' Trench Width 36" Max Trench Bottom Depth 36" Gravel Depth N/A

[X] New System [ ] Repair [ ] Expansion System Type: [ ] II [ ] III [ ] IV [ ] V [ ] VI

System Description: Gravity - 25% Reduction

Repair System Description: Pump - Panel Block

Maintenance Agreement Required: [ ] Yes [X] No

[X] House/Mod. Home [ ] Mobile Home [ ] Business [ ] Other

No. Bedrooms 4 No. Persons ____ No. Employees ____


Water Supply: [X] Individual [ ] Public [ ] Community

[X] Gravity [ ] Pressure [ ] Slab [X] Crawl Space [ ] Basement w/plumbing [ ] Basement wo/plumbing

Comments/Conditions: Stay 10' From PL & 50' From any well.

Comments/Conditions: Note: Old Existing Septic System located under Proposed Home to be abandoned. Stay 50' From wells if only 1 household connected otherwise 100' setback

PL 300' INITIAL SITE SKETCH Scale 1:60'

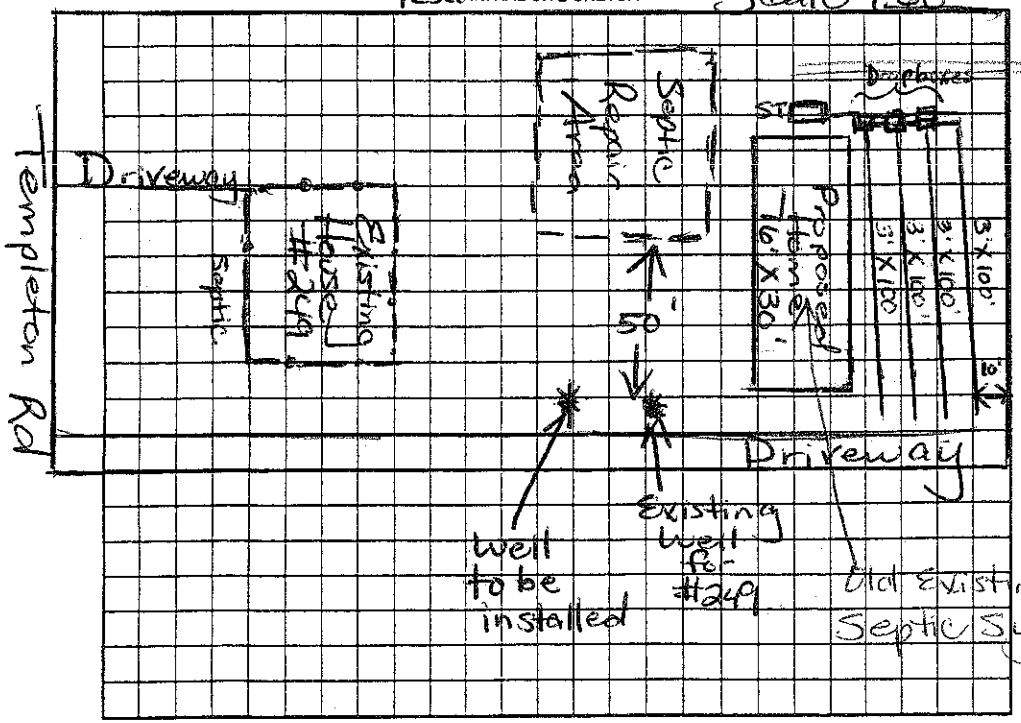

AS BUILT SKETCH

black poly lok filter
Quick 4' Chambers installed
as per initial sketch

Permit can be suspended or revoked if any false information is supplied toward securing the permit/any unauthorized changes are made to the site/any unauthorized changes are made in the installation of the system. Improvement Permit with plat valid without expiration ☐ Improvement Permit with site plan valid for sixty months ☐ Authorization to Construct is valid for a period equal to that of Improvement Permit – not to exceed sixty months.

Signed: [signature] date 1-9-06

Improvement Permit by: Maria H. Colson RS date 1/9/06

Authorization to Construct by: Maria H. Colson RS date 1/9/06

Installed by: Stanley Septic Tank

Operation Permit by: Andy McNeill date 2-16-06

Existing System Inspection by: ____ date ____

HEALTH DEPT. COPY: WHITE OWNER COPY (FINAL): YELLOW OWNER COPY (INITIAL): PINK