#110282

10:00 AM

IREDELL COUNTY HEALTH DEPARTMENT

STATESVILLE 704-878-5305 MOORESVILLE 704-664-5281

IMPROVEMENT PERMIT / AUTHORIZATION TO CONSTRUCT / OPERATION PERMIT / EXISTING SYSTEM INSPECTION

PERMIT# 225 MRSUL 110282 PIN# 4645-59-2250 4645-48-2896 DATE Nov. 30, 01

OWNER OR CONTRACTOR Ernst Enterprises Inc. // St Lawrence Homes PHONE: Business _____ Home _____

ADDRESS 125 Easton Dr. Mooresville NC 28117

LOCATION 215 TL Alcove TR Templeton TR Templeton Bay TL Greenfield on left near end #107

SUBDIVISION Templeton Bay BLOCK / SECTION _____ LOT 11 LOT AREA 23,583ft² SITE CLASS: PS 1956 DESIGN FLOW 480gpd L.T.A.R. .03

Septic Tank: 1000 Gallons; STB 312 Date 2-17-03

Pump Tank: 1000 Gallons; PT 27 Date 2-19-03

Pump Make: Myers Model ME3F-11 Serial No. _____

Nitrification Field: No Fields 1 Square Feet 540/810 Linear Feet 270

No Lines 6@45 Trench Width 24"MIN 86" Max Trench Bottom Depth 36" Gravel Depth NA

☑ New System ☐ Repair System Type: I, II, III, ⓘ V, VI

System Description: LP PPBPS

Repair System Description: same

Maintenance Agreement Required: ☑ Yes ☐ No

~~☐ House/Mod. Home~~ No. Bedrooms 4

☐ Mobile Home No. Bathrooms 4

☐ Business No. Employees _____

☐ Other _____

☐ Slab ☑ Crawl Space ☐ Basement w/plumbing ☐ Basement wo/plumbing

Water Supply: ☐ Individual ~~☐ Public~~ ~~☐ Community~~

Comments/Conditions: OR 36"Max 90c

Do not cut house site. Backfill against foundation to provide positive drainage. Remove any old bulkheads in septic system area.


Comments/Conditions: Need to Check Filter

Checked tanks & lines 4/3/03


Checked pressure, electrical alarm 4/4/03

1"=50'

INITIAL SITE SKETCH

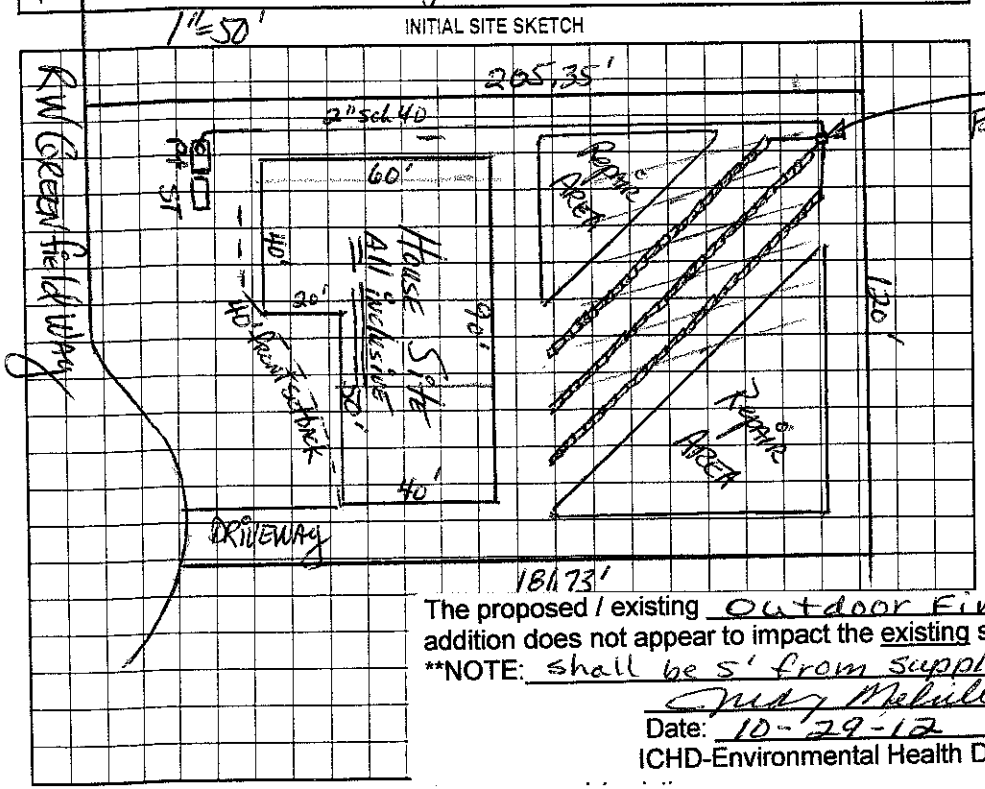

AS BUILT SKETCH

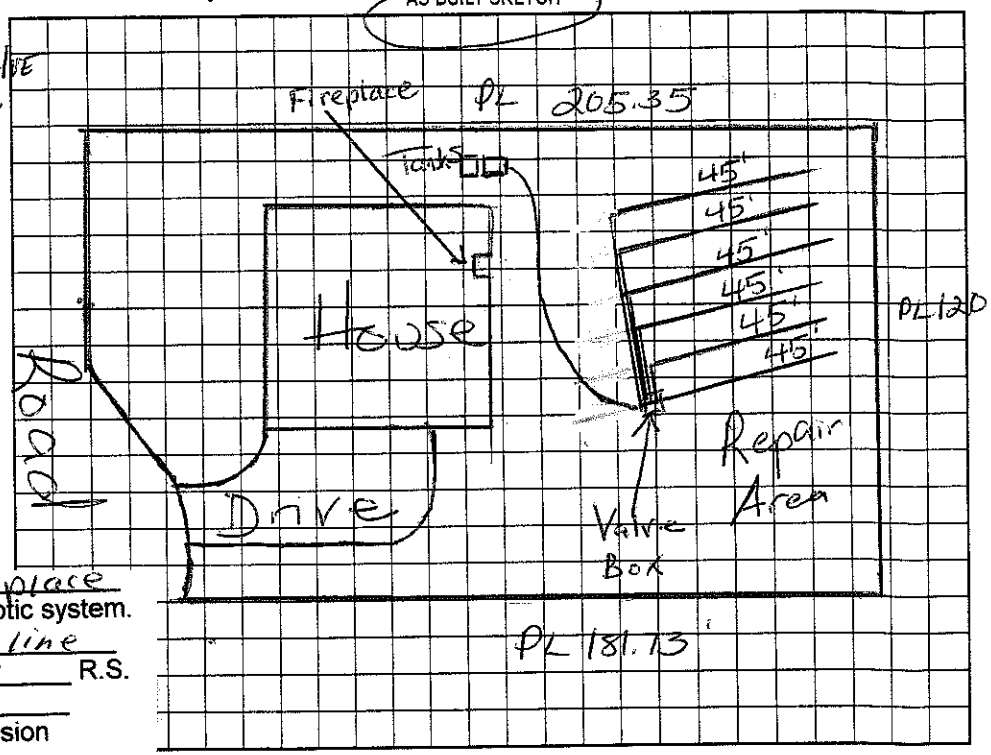

The proposed / existing Outdoor Fireplace addition does not appear to impact the existing septic system.

**NOTE: shall be 5' from supply line

Cindy Melville R.S.

Date: 10-29-12

ICHD-Environmental Health Division

Permit can be suspended or revoked if any false information is supplied toward securing the permit/any unauthorized changes are made to the site/any unauthorized changes are made in the installation of the system. Improvement Permit with plat valid without expiration. Improvement Permit with site plan valid for sixty months. Authorization to Construct is valid for a period equal to that of Improvement Permit – not to exceed sixty months.

Signed: Robert Ernst date 11/6/02 Installed by: B&H Inc.

Improvement Permit by: [signature] RS date 11-30-01 Operation Permit by: Maria Dotson RS date 4/17/03

Authorization to Construct by: [signature] RS date 1-6-03 Existing System Inspection by: _____ date _____

HEALTH DEPT. COPY: WHITE OWNER COPY (FINAL): YELLOW OWNER COPY (INITIAL): PINK