#110985

IREDELL COUNTY HEALTH DEPARTMENT

STATESVILLE 704-878-5305 MOORESVILLE 704-664-5281

IMPROVEMENT PERMIT / AUTHORIZATION TO CONSTRUCT / OPERATION PERMIT / EXISTING SYSTEM INSPECTION

PERMIT# 225 Mod. PIN# ~~4645-59-2250~~ 4645-48-4813 DATE Nov. 21,01

OWNER OR CONTRACTOR Digest Enterprises Inc. / St Lawrence HOME PHONE: Business _____ Home _____

ADDRESS 125 Easton Dr. Mooresville NC. 28117

LOCATION 21.5, TL Alcove TR Templeton TR Templeton Bay, T/L Greenfield on left

SUBDIVISION Templeton Bay BLOCK / SECTION _____ LOT 10 LOT AREA 24,642ft² SITE CLASS: PS, NSE DESIGN FLOW 480gpd L.T.A.R. .2-.25

Septic Tank: 1000 Gallons; STB 794 Date 4-6-03
Pump Tank: 1000 Gallons; PT 27 Date 4-28-03
Pump Make: Myers Model ME 50521 Serial No. 25325D069
Nitrification Field: No Fields 1 Square Feet 720/1080 Linear Feet 360
No Lines 4@90' Trench Width 24" MIN Bloc Max Trench Bottom Depth 30" Gravel Depth NA

☑ New System ☐ Repair System Type: I, II, III, IV, V, VI
System Description: LPP BBS
Repair System Description: SAME
Maintenance Agreement Required: ☑ Yes ☐ No

☑ House/Mod. Home ☐ Mobile Home ☐ Business ☐ Other
No. Bedrooms 4 No. Bathrooms 4 No. Employees ____

☐ Slab ☑ Crawl Space ☐ Basement w/plumbing ☐ Basement wo/plumbing


Water Supply: ☐ Individual ☑ Public ☑ Community

Comments:/Conditions: OR 36" MAX 90 oc
Do not cut house site. Backfill against foundation to provide positive drainage. Remove any old berms & hedgerows in septic system area.


Comments:/Conditions:
* Tanks checked 6/13/03 MD. put in back of house along deck lines, pressure, elect & alarms checked 6/20/03

1" = 50'

INITIAL SITE SKETCH

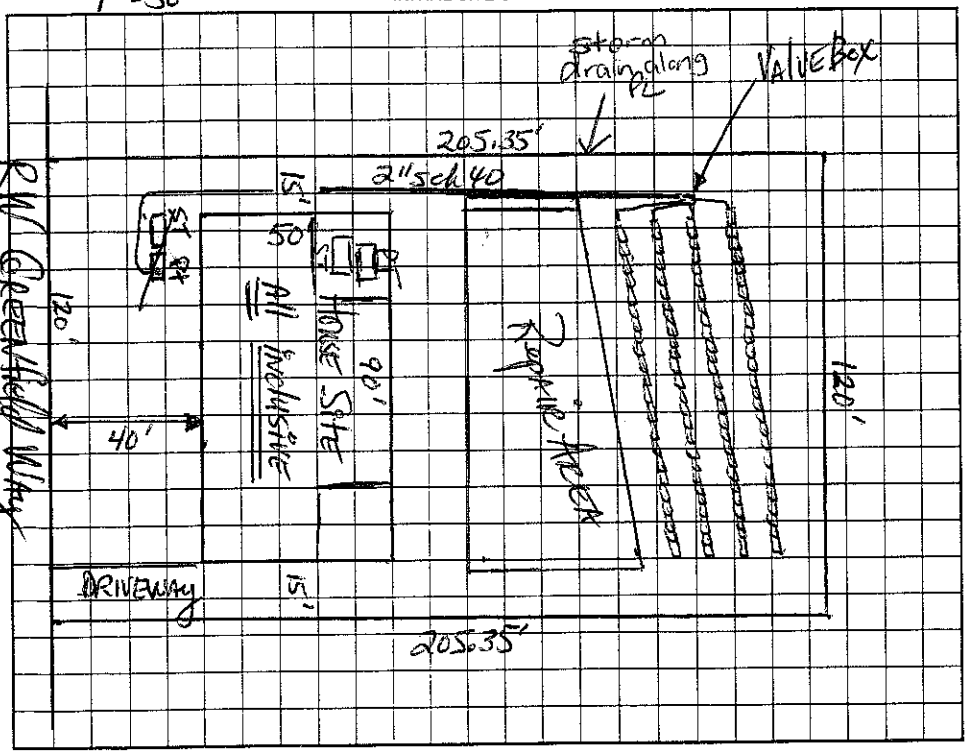

AS BUILT SKETCH

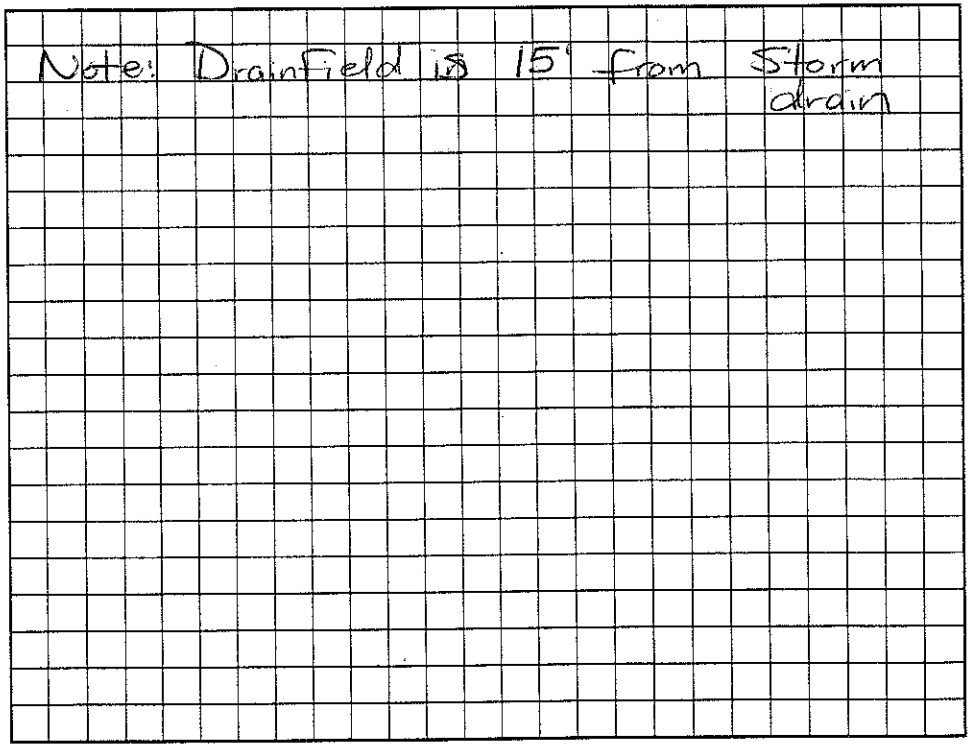

Permit can be suspended or revoked if any false information is supplied toward securing the permit/any unauthorized changes are made to the site/any unauthorized changes are made in the installation of the system. Improvement Permit with plat valid without expiration. Improvement Permit with site plan valid for sixty months. Authorization to Construct is valid for a period equal to that of Improvement Permit – not to exceed sixty months.

Signed: Robert Bridges date 1/16/02
Improvement Permit by: Mark Simmons, RS date 11-21-01
Authorization to Construct by: [signature] RS date 1/27/03

Installed by: R & H Inc
Operation Permit by: Mark Simmons R.S. date 6/23/03
Existing System Inspection by: _____ date _____

HEALTH DEPT. COPY: WHITE OWNER COPY (FINAL): YELLOW OWNER COPY (INITIAL): PINK