4645487126

IREDELL COUNTY HEALTH DEPARTMENT

Statesville Phone TR 3-7271 Mooresville Phone NO 3-1271

PERMIT TO INSTALL SEPTIC TANK

Permit NO. Terry White Permit Date Oct. 9 1963

Owner Robert Thompson Address Mooresville, N.C.

Installed By Oswalt + Norwalk Address Troutman, N.C.


Location of Property Templeton Rd.

Tank		Capacity		Length of Lines		Fixtures	
Block	(X)	800	( )	150'	( )	No. of Baths	( )
Precast	( )	900	( )	175'	( )	Dishwasher	( )
		1000	(X)	200'	( )	Garbage Grdr.	( )
		1100	( )	225'	(X)	Auto-Washer	( )
		1200	( )	250'	( )	Other	
		Other		Other			

NOTIFY HEALTH DEPARTMENT AT LEAST EIGHT HOURS BEFORE TANK IS TO BE INSPECTED.

Final Inspection Oct 9 1963 Approved (X) Disapproved ( )

Remarks

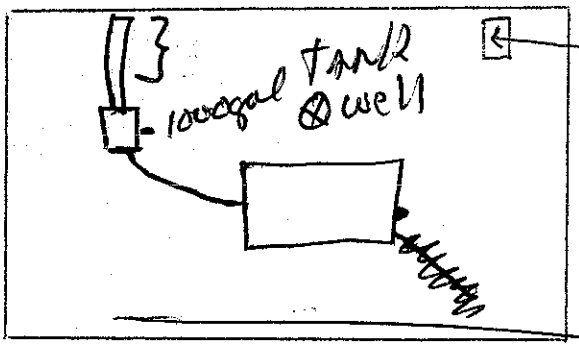

Sketch of Installation

Ruby Lee Sanitarian

The proposed / existing Deck 10'x19'
addition does not appear to impact the existing septic system.
**NOTE:

REHS
Date: 5-10-10
ICHD-Environmental Health Division

The proposed / existing Accessory Building
addition does not appear to impact the existing septic system
**NOTE: 25'+ from well, 5'+ from septic

Judy Melville REHS
Date: 5-26-11
ICHD-Environmental Health Division