IREDELL COUNTY HEALTH DEPARTMENT

Redraw

STATESVILLE 704-878-5305 MOORESVILLE 704-664-5281

IMPROVEMENT PERMIT / AUTHORIZATION TO CONSTRUCT / OPERATION PERMIT / EXISTING SYSTEM INSPECTION

PERMIT# 074171 PIN# 4645487591 DATE 8/7/98

OWNER OR CONTRACTOR Mabel O. Farrington PHONE: Business Larry Beam's Pager 565-7170 Home 663-4084

ADDRESS 108 Overcash Farm Rd Mooresville, NC 28115

LOCATION Al Cove Rd TR Templeton Corner of Overcash & Templeton

SUBDIVISION _____ BLOCK / SECTION _____ LOT _____ LOT AREA Acreage SITE CLASS. PS DESIGN FLOW 360 gpd L.T.A.R. .3

Septic Tank: 1000 Gallons; STB 7024 Date 7/14/98

Pump Tank: _____ Gallons; PT _____ Date _____

Pump Make: _____ Model _____ Serial No. _____

Nitrification Field: No Fields 1 Square Feet 1200' Linear Feet 400'

No Lines 3 @ 133' Trench Width 36" Max Trench Bottom Depth 28" Gravel Depth 12"

☒ New System ☐ Repair System Type: I, II, III, IV, V, VI

System Description: Gravity - Conventional

Repair System Description: Deeded prior to 1982

Maintenance Agreement Required: ☐ Yes ☒ No

☐ House/Mod. Home ☒ Mobile Home ☐ Business ☐ Other

No. Bedrooms 3 No. Bathrooms 2 No. Employees ____

☐ Slab ☒ Crawl Space ☐ Basement w/plumbing ☐ Basement wo/plumbing


Water Supply: ☒ Individual Shared ☐ Public 2 Family ☐ Community

Comments:/Conditions: Keep Septic System at least 5' from House & 100' from well. (* Middle part of line may be a little deeper than ends.)

Comments:/Conditions:

INITIAL SITE SKETCH

Scale 1:60

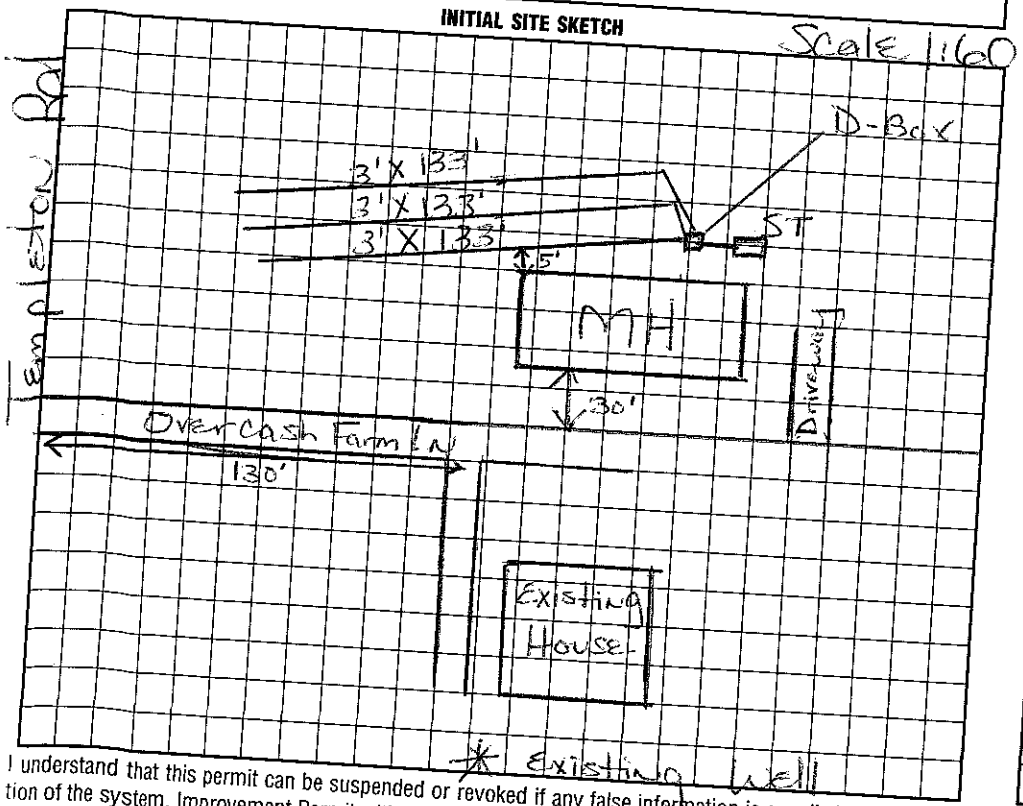

AS BUILT SKETCH

I understand that this permit can be suspended or revoked if any false information is supplied toward securing the permit/any unauthorized changes are made to the site/any unauthorized changes are made in the installation of the system. Improvement Permit with plat valid without expiration. Improvement Permit with site plan valid for sixty months. Authorization to Construct is valid for a period equal to that of Improvement Permit – not to exceed sixty months.

Signed: _____

Improvement Permit by: Maria H. Dotson date _____

Authorization to Construct by: Maria H. Dotson date 8/10/98

Installed by: LARRY BEAM

Operation Permit by: C. Ray Tyson date 8/10/98

Existing System Inspection by: _____ date 10/6/98

HEALTH DEPT. COPY: WHITE INSPECTION COPY (FINAL): GREEN OWNER COPY (FINAL): YELLOW INSPECTION COPY (INITIAL): PINK OWNER COPY (INITIAL): GOLD