126 956

IREDELL COUNTY HEALTH DEPARTMENT

STATESVILLE 704-878-5305 MOORESVILLE 704-664-5281

IMPROVEMENT PERMIT / AUTHORIZATION TO CONSTRUCT / OPERATION PERMIT / EXISTING SYSTEM INSPECTION

PERMIT# 225 Mrsol. PIN# ~~4645-59-2250~~ 4645-48-7755 DATE Nov. 21, 01

OWNER OR CONTRACTOR Dienst Enterprises Inc. / St. Lawrence PHONE: Business Home

ADDRESS 125 Easton Dr. Mooresville N.C. 28117

LOCATION 215. TL Alcove TR Templeton TR Templeton Bay TL Greenfield on left

SUBDIVISION Templeton Bay BLOCK / SECTION LOT 7 LOT AREA 24,042 ft² SITE CLASS. PS for 1936 DESIGN FLOW 480 gpd L.T.A.R. .23

Septic Tank: 1600 Gallons; STB 312 Date 4/20/04
Pump Tank: 1000 Gallons; PT 283 Date 5/25/05
Pump Make: Model Serial No.
Nitrification Field: No Fields 1 Square Feet 540/810 Linear Feet 270
No Lines 4 Trench Width 24" min 8'oc Max Trench Bottom Depth 36" Gravel Depth NA

☑ New System ☐ Repair System Type: I. II. III. ⓘ V. VI
System Description: LP PPBPS
Repair System Description: SAME
Maintenance Agreement Required: ☑ Yes ☐ No

☑ House/Mod. Home No. Bedrooms 4
☐ Mobile Home No. Bathrooms 4
☐ Business No. Employees
☐ Other

☐ Slab ☑ Crawl Space ☐ Basement w/plumbing ☐ Basement wo/plumbing


Water Supply: ☐ Individual ☑ Public ☑ Community

Comments:/Conditions: OR 36" MAP 9'oc
Do not cut house site, Backfill only against foundation
Remove any old burns in septic system area.

Comments:/Conditions: Reviewed Building plans & site plan; Need to move tanks to right side line if driveway is on left. MD
Checked lines 7/11/05 MD

INITIAL SITE SKETCH

1"=50'

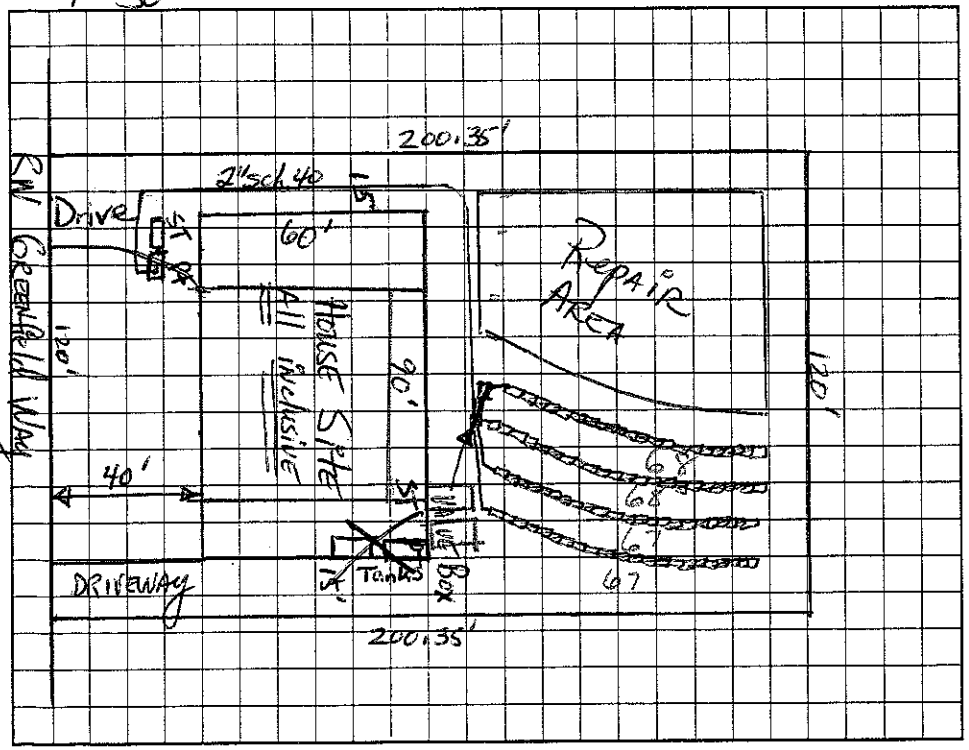

AS BUILT SKETCH

Pressure, elect & alarm 7/13/05

Drain lines installed essentially as Drawn

Permit can be suspended or revoked if any false information is supplied toward securing the permit/any unauthorized changes are made to the site/any unauthorized changes are made in the installation of the system. Improvement Permit with plat valid without expiration. Improvement Permit with site plan valid for sixty months. Authorization to Construct is valid for a period equal to that of Improvement Permit – not to exceed sixty months.

Signed: Robert By Dienst date 11/16/02

Improvement Permit by: [signature] RS date 11-21-01

Authorization to Construct by: Maria H Dotson RS date 3/9/05

Installed by: R&H date

Operation Permit by: Maria H Dotson RS date 7/13/05

Existing System Inspection by: date

HEALTH DEPT. COPY: WHITE OWNER COPY (FINAL): YELLOW OWNER COPY (INITIAL): PINK