IREDELL COUNTY HEALTH DEPARTMENT

STATESVILLE 704-878-5305 MOORESVILLE 704-664-5281

IMPROVEMENT PERMIT / AUTHORIZATION TO CONSTRUCT / OPERATION PERMIT / EXISTING SYSTEM INSPECTION

PERMIT# 122841 PIN# ~~4644559 2250~~ 4645492143 Chris DATE 11-2-04

OWNER OR CONTRACTOR St Lawrence Homes PHONE: Business 201-9297 Home

ADDRESS 7930 Kenton Circle Ste 160 Huntersville NC 28078 Huntfield Way

LOCATION 215 TL Alcove TR Templeton TR Templeton Bay TL Greenfield at end on right

SUBDIVISION Templeton Bay BLOCK / SECTION LOT 14 LOT AREA 43,236 SITE CLASS PS DESIGN FLOW 480gpd L.T.A.R. .3

Septic Tank: 1000 Gallons; STB 312 Date 10-5-04 ☒ New System ☐ Repair System Type: I II III IV V VI ☒ House/Mod. Home No. Bedrooms 4

Pump Tank: 1000 Gallons; PT 27 Date 10-4-04 System Description: Pump (PM) 25% Reduction ☐ Mobile Home No. Bathrooms 4


Pump Make: Goulds Model WE0312 Serial No. Repair System Description: pm/ld 25% Red. ☐ Business No. Employees

Nitrification Field: No Fields 1 Square Feet 1200 Linear Feet 400 Maintenance Agreement Required: ☐ Yes ☒ No ☐ Other

No Lines 5@80' Trench Width 36" Max Trench Bottom Depth 36" Gravel Depth N/A ☐ Slab ☒ Crawl Space ☐ Basement w/plumbing ☐ Basement wo/plumbing


Water Supply: ☐ Individual ☒ Public ☐ Community

Comments:/Conditions: 6@70' PL 329.54 Scale 1:50

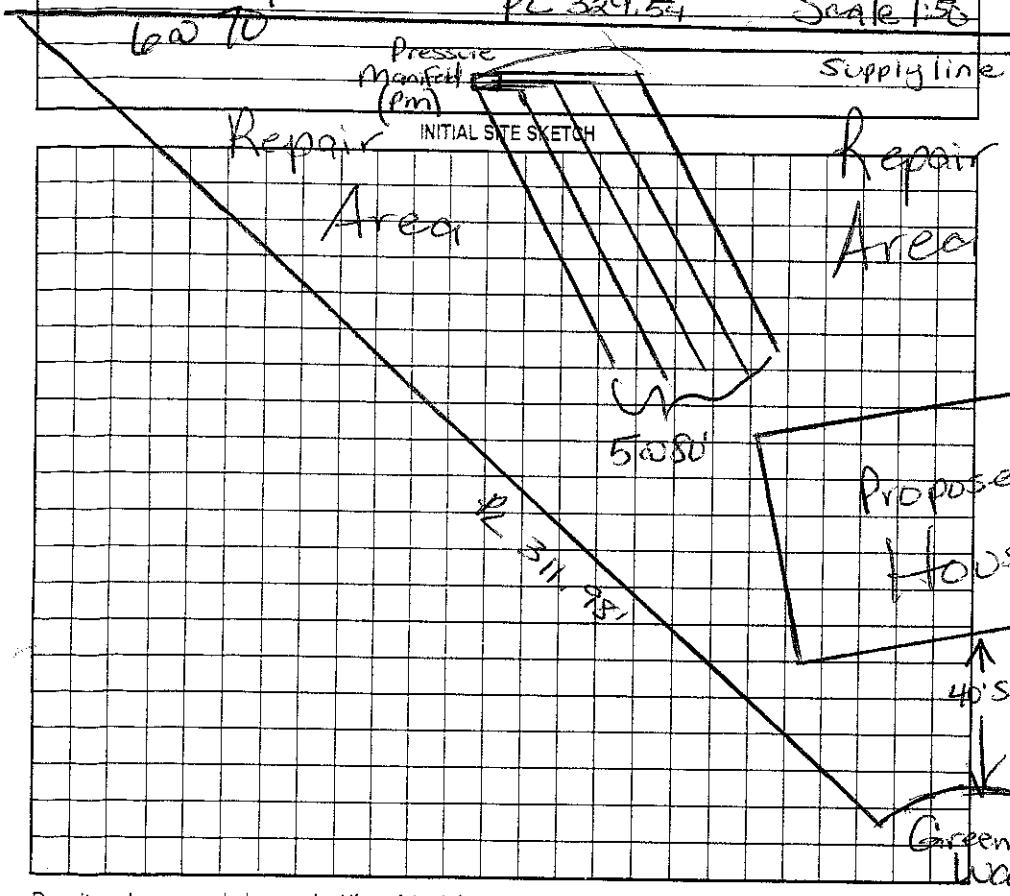

INITIAL SITE SKETCH

Comments:/Conditions: Remove old farm burms in Drainfield. Do not cut backfill against foundation.

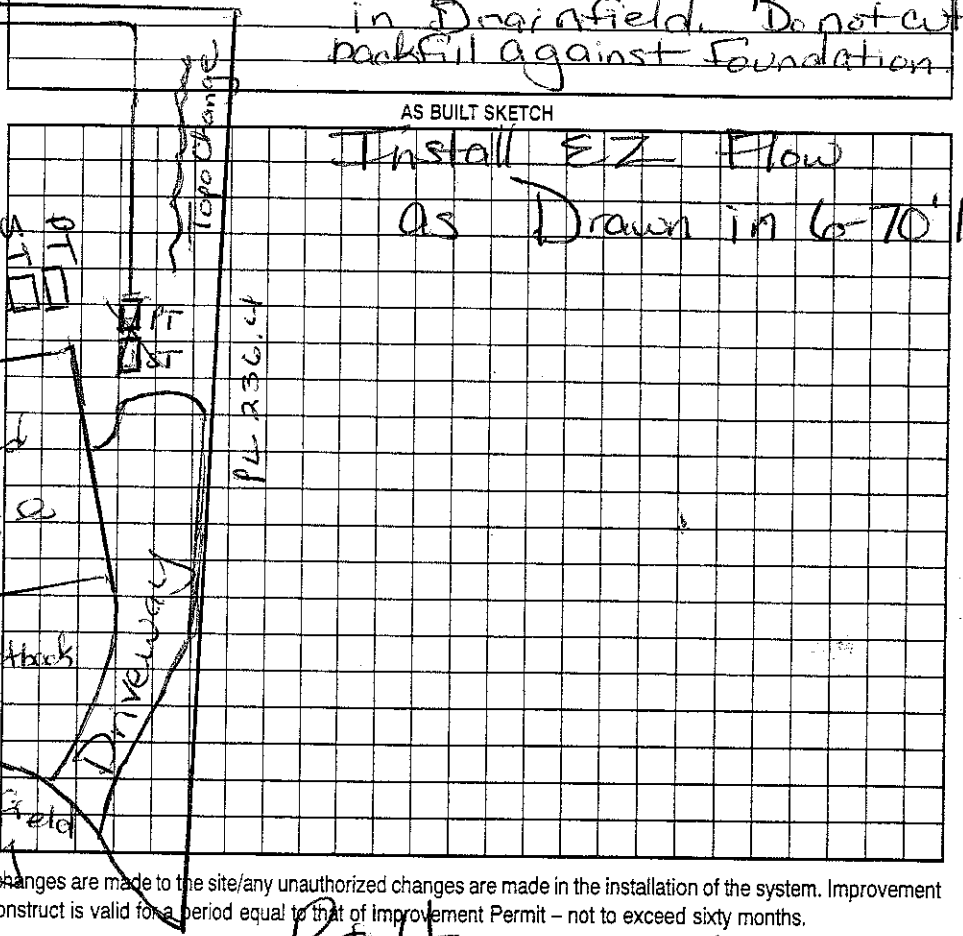

AS BUILT SKETCH

Install EZ Flow as Drawn in 6-70' lines

Permit can be suspended or revoked if any false information is supplied toward securing the permit/any unauthorized changes are made to the site/any unauthorized changes are made in the installation of the system. Improvement Permit with plat valid without expiration. Improvement Permit with site plan valid for sixty months. Authorization to Construct is valid for a period equal to that of Improvement Permit – not to exceed sixty months.

Signed: Christopher Vick date 11/15/04 Installed by: R & H

Improvement Permit by: Maria H. Dotson RS date 11/12/04 Operation Permit by: Maria H. Dotson RS date 11/19/04

Authorization to Construct by: Maria H. Dotson RS date 11/12/04 Existing System Inspection by: date

HEALTH DEPT. COPY: WHITE OWNER COPY (FINAL): YELLOW OWNER COPY (INITIAL): PINK