IREDELL COUNTY HEALTH DEPARTMENT

STATESVILLE 704-878-5305 245.00 Paid MOORESVILLE 704-664-5281

IMPROVEMENT PERMIT / AUTHORIZATION TO CONSTRUCT / OPERATION PERMIT / EXISTING SYSTEM INSPECTION

PERMIT# 225 Mooresville PIN# ~~4645559235~~ 4645-49-5373 DATE 12-13-2002

OWNER OR CONTRACTOR Dienst Enterprise Inc/Beazer Homes PHONE: Business 309-0123 Home

ADDRESS 125 Easton Dr. Mooresville NC 28117

LOCATION 21.5 over I-77 TL Alcove TR Templeton TR Templeton Bay TL Katie Spencer on right

SUBDIVISION Templeton Bay BLOCK / SECTION LOT 23 LOT AREA 47070ft² SITE CLASS. 45 DESIGN FLOW 480gpd L.T.A.R. ~ .3-.25

Septic Tank: 1000 Gallons; STB 312 Date

Pump Tank: 1000 Gallons; PT 283 Date

Pump Make: Goulds Model WE0712H Serial No. M045424

Nitrification Field: No Fields 1 Square Feet 960 Linear Feet 320

No Lines 3 Trench Width 36" Max Trench Bottom Depth 30" Gravel Depth N/A

☒ New System ☐ Repair System Type: I II III IV V VI Type 4

System Description: Pump-LP-Panel Block

Repair System Description: Same

Maintenance Agreement Required: ☒ Yes ☐ No

☒ House/Mod. Home ☐ Mobile Home ☐ Business ☐ Other

No. Bedrooms 4 No. Bathrooms 4 No. Employees


☐ Slab ☒ Crawl Space ☒ Basement w/plumbing ☐ Basement wo/plumbing

Water Supply: ☐ Individual ☒ Public ☒ Community


Comments/Conditions: Remove any old burms in Septic System area. Keep Septic System at least 10' from PL & 50' from lake

Comments/Conditions: Use In line filter on pump.
73 Panels
3/16" holes

INITIAL SITE SKETCH Scale 1:15

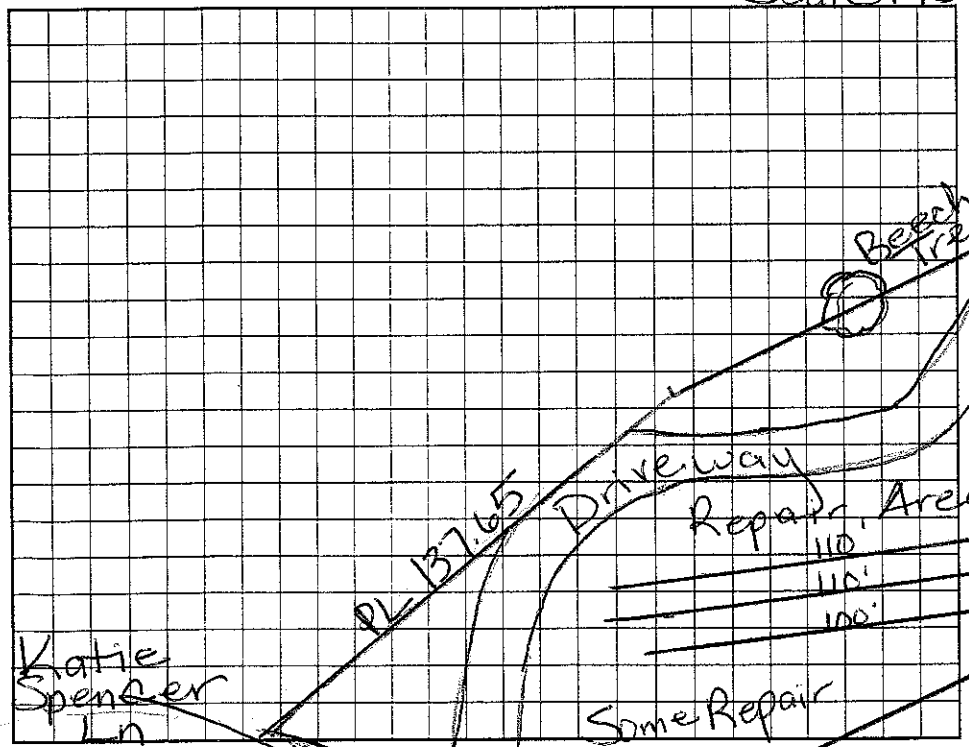

AS BUILT SKETCH

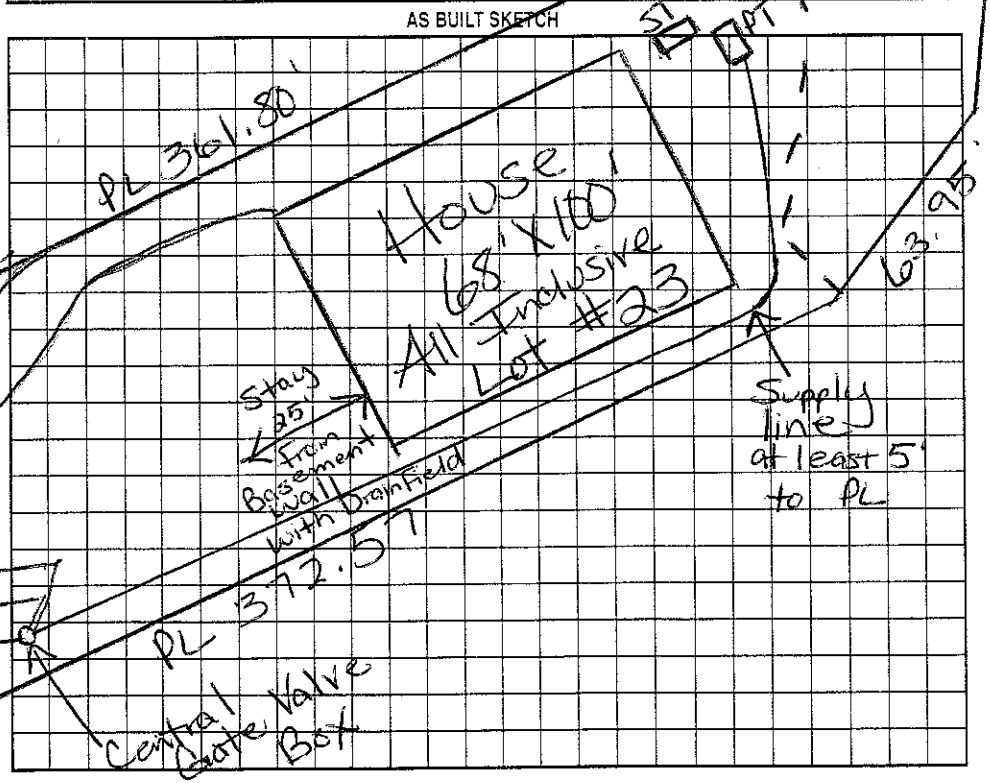

Permit can be suspended or revoked if any false information is supplied toward securing the permit/any unauthorized changes are made to the site/any unauthorized changes are made in the installation of the system. Improvement Permit with plat valid without expiration. Improvement Permit with site plan valid for sixty months. Authorization to Construct is valid for a period equal to that of Improvement Permit – not to exceed sixty months.

Signed: Robert B. Dienst date 1-15-03 Installed by: F+S Plumbing

Improvement Permit by: Maria H. Dalgan RS date 12/13/02 Operation Permit by: RS date 1/26/05

Authorization to Construct by: RS date 6/8/04 Existing System Inspection by: date

HEALTH DEPT. COPY: WHITE OWNER COPY (FINAL): YELLOW OWNER COPY (INITIAL): PINK