126073

IREDELL COUNTY HEALTH DEPARTMENT

STATESVILLE 704-878-5305 MOORESVILLE 704-664-5281

IMPROVEMENT PERMIT / AUTHORIZATION TO CONSTRUCT / OPERATION PERMIT / EXISTING SYSTEM INSPECTION

PERMIT# 225 MRSU. PIN# 4645-59-2250 4645-49-6072 DATE Nov. 30, 01

OWNER OR CONTRACTOR ~~Diehl Enterprises Inc~~ St. Lawrence PHONE Business Home

ADDRESS 125 Easton Dr. Mooresville N.C. 28117

LOCATION 215 TL Alcove TR Templeton TR Templeton Bay TL Greenfield on Right at jct w/ Katie Spencer Lane

SUBDIVISION Templeton Bay BLOCK / SECTION LOT 151 LOT AREA 30,027 ft² SITE CLASS. RS DESIGN FLOW 480gpd L.T.A.R. .3

Septic Tank: 1000 Gallons; STB ~~312~~ 312 Date 5/3/04

Pump Tank: 1000 Gallons; PT 27 Date 4/30/05

Pump Make: Model Serial No.

Nitrification Field: No Fields 1 Square Feet 600/900 Linear Feet 300

No Lines 3 Trench Width 24" min 36" Max Trench Bottom Depth 36"

☑ New System ☐ Repair System Type: I, II, III, IV, V, VI

System Description: LPPBPS

Repair System Description: SAME

Maintenance Agreement Required: ☑ Yes ☐ No

Gravel Depth NA

☑ House/Mod. Home No. Bedrooms 4

☐ Mobile Home No. Bathrooms 4

☐ Business No. Employees

☐ Other

☐ Slab ☑ Crawl Space ☐ Basement w/plumbing ☐ Basement wo/plumbing


Water Supply: ☐ Individual ☑ Public ☑ Community

Comments/Conditions: OR-36" max 9'oc

Remove o/s hedgerow & berm in septic area

Comments/Conditions: Note: Reviewed Building plans & Site Plan 1/12/05. Plan will work if Builder stays within Original Building envelope.

INITIAL SITE SKETCH 1:50

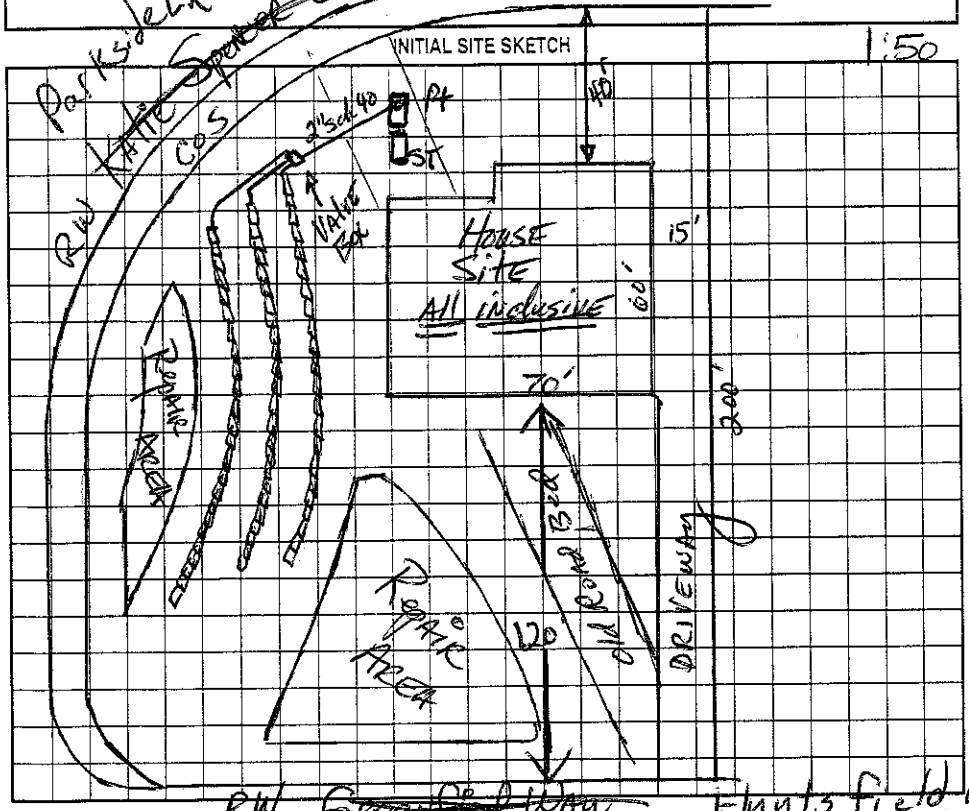

AS BUILT SKETCH

Tanks, lines, press, elect & alarm Checked by GM

Permit can be suspended or revoked if any false information is supplied toward securing the permit, any unauthorized changes are made to the site/any unauthorized changes are made in the installation of the system. Improvement Permit with plat valid without expiration. Improvement Permit with site plan valid for sixty months. Authorization to Construct is valid for a period equal to that of Improvement Permit – not to exceed sixty months.

Signed: Robert Bryant date 1/16/02

Improvement Permit by: [signature] RS date 11-30-01

Authorization to Construct by: Maia Hill Dolson RS date 1/12/05

Installed by: R+H date

Operation Permit by: Maia Hill Dolson RS date 6/17/05

Existing System Inspection by: date

HEALTH DEPT. COPY: WHITE OWNER COPY (FINAL): YELLOW OWNER COPY (INITIAL): PINK