IREDELL COUNTY HEALTH DEPARTMENT

IMPROVEMENT PERMIT / AUTHORIZATION TO CONSTRUCT / OPERATION PERMIT / EXISTING SYSTEM INSPECTION

STATESVILLE 704-878-5305 MOORESVILLE 704-664-5281

50.00 Paid 3:00

PERMIT# 225 Mrsvl PIN# 4645592250 4645-49-6376

OWNER OR CONTRACTOR Dienst Enterprises Inc // St Lawrence Homes PHONE: Business 309-0123 DATE 9-17-2002

ADDRESS 125 Easton Dr. Mooresville NC 28117 Home

LOCATION Williamson Rd TL Alcove TR Templeton Bay TR Templeton Bay TL Katie Spencer on left

SUBDIVISION Templeton Bay BLOCK / SECTION LOT 24 LOT AREA SITE CLASS. PS DESIGN FLOW 480gpd L.T.A.R. .3

Septic Tank: 1000 Gallons; ST# 194 Date 4-27-03

Pump Tank: 1000 Gallons; PT# 283 Date 3-21-03

Pump Make: Myers Model ME50 Serial No.

Nitrification Field: No Fields 1 Square Feet 540-810 Linear Feet 270'

No Lines 3@90' Trench Width 24"-36" Max Trench Bottom Depth 36" Gravel Depth N/A

☒ New System ☐ Repair System Type: I. II. III. IV. V. VI

System Description: Pump (LP) Panel Block

Repair System Description: Same

Maintenance Agreement Required: ☒ Yes ☐ No

☒ House/Mod. Home ☐ Mobile Home ☐ Business ☐ Other

No. Bedrooms 4 No. Bathrooms 4 No. Employees


☐ Slab ☒ Crawl Space ☒ Basement w/plumbing ☐ Basement wo/plumbing

Water Supply: ☐ Individual ☒ Public ☒ Community


Comments/Conditions: Remove any old berms in Septic System area. Keep Septic System at least 10' from PL, 50' from lake & 25' from basement wall.

Comments/Conditions: Do not cut/grade down for driveway

INITIAL SITE SKETCH Scale 1"=50'

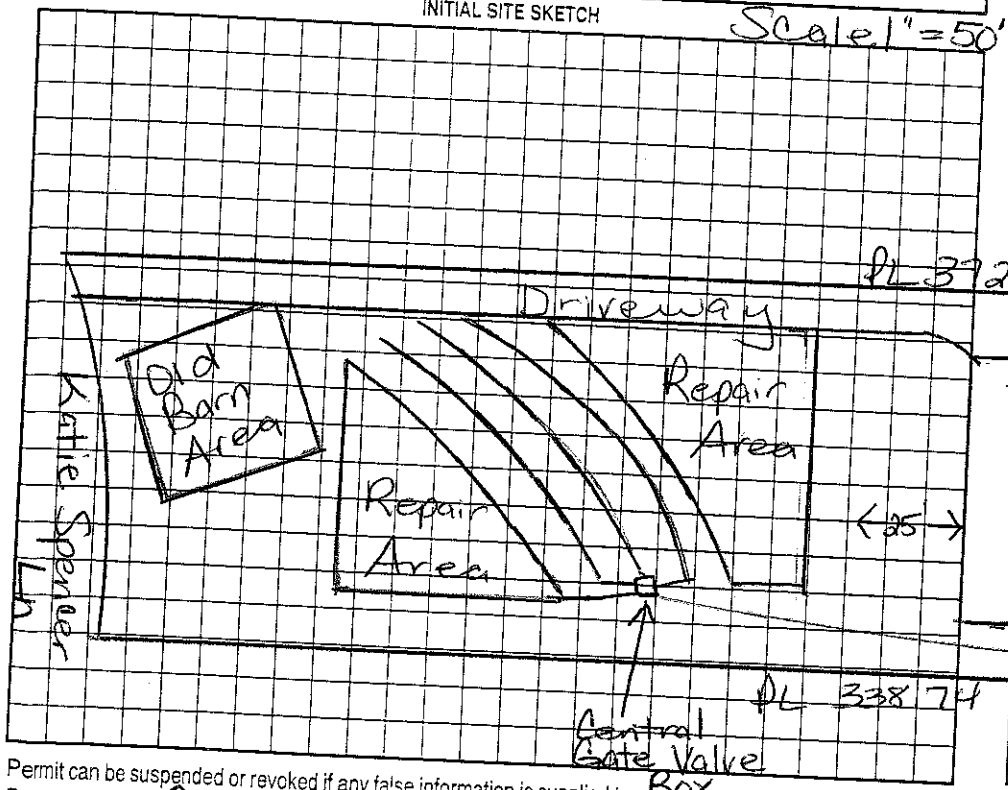

AS BUILT SKETCH

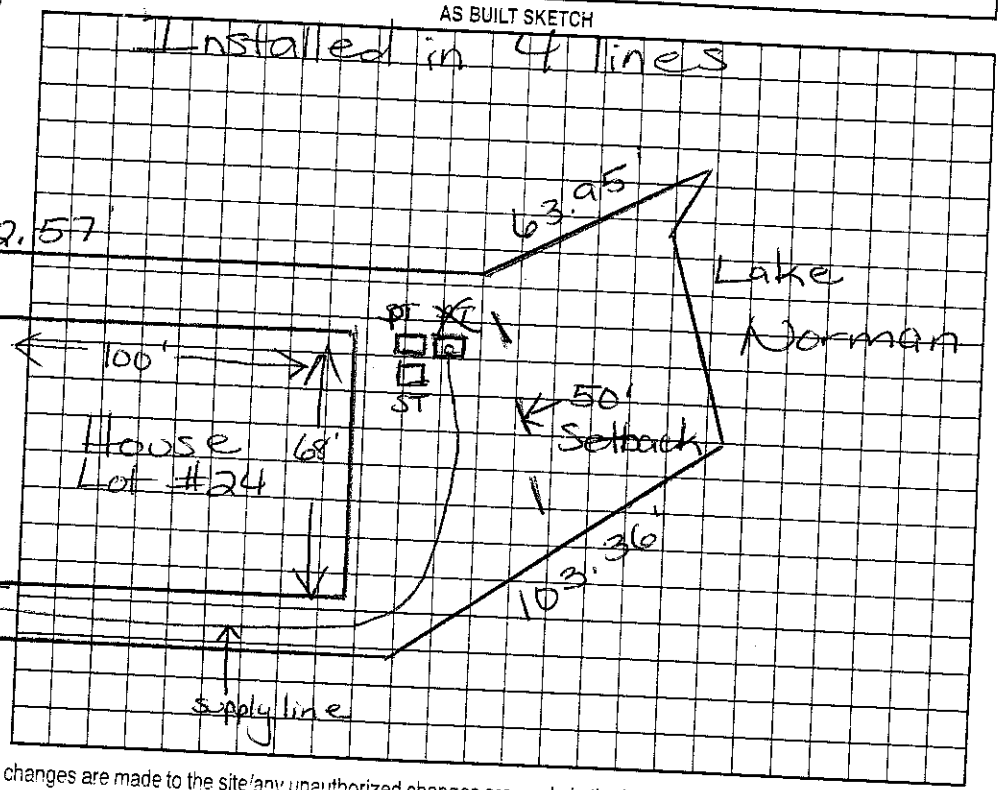

Permit can be suspended or revoked if any false information is supplied toward securing the permit/any unauthorized changes are made to the site/any unauthorized changes are made in the installation of the system. Improvement Permit with plat valid without expiration. Improvement Permit with site plan valid for sixty months. Authorization to Construct is valid for a period equal to that of Improvement Permit – not to exceed sixty months.

Signed: Robert L. Dienst

Improvement Permit by: Marvin H. Dolan RS date 9/17/02 Installed by: R & H

Authorization to Construct by: date 2-28-03 Operation Permit by: Marvin H. Dolan RS date 4/27/03

Existing System Inspection by: date

HEALTH DEPT. COPY: WHITE OWNER COPY (FINAL): YELLOW OWNER COPY (INITIAL): PINK