IREDELL COUNTY HEALTH DEPARTMENT
ENVIRONMENTAL HEALTH DIVISION
Application For Improvement Permit
Site Plan Form

INSTRUCTIONS TO APPLICANT: (Items in Parentheses are to be performed by DEVELOPERS ONLY)

All property corners must be staked and flagged with dimensions matching those shown on an approved final (preliminary) plat (**and** proposed house dimensions must be staked and flagged) before the Iredell County Health Department can begin review work on this proposed site. An application for an Improvement Permit is considered complete **only** when this site plan form is completed, signed, and attached to the application form.

As Close To Scale As Is Possible: 1. Draw in the proposed lot showing **all** proposed lot dimensions and orientation to proposed streets or roads. 2. Draw in the proposed structure showing dimensions and distances to property lines (include decks, walkways, etc.). E. Draw in the proposed driveway location. 4. Draw in all wells, both existing and proposed, including those on adjacent property (if known). 5. Draw in any other structure ie. sheds, outbuildings, pools, etc. which will occupy space on the proposed lot.

See Attached
Permit and/or
site Plan

I hereby convenant that the above representation is correct to the best of my knowledge and ability.

_____Date_____SIGNATURE OF OWNER/AUTHORIZED AGENT

IREDELL COUNTY HEALTH DEPARTMENT

STATESVILLE 704-878-5305 MOORESVILLE 704-664-5281

IMPROVEMENT PERMIT / AUTHORIZATION TO CONSTRUCT / OPERATION PERMIT / EXISTING SYSTEM INSPECTI

PERMIT# 225 MRSVL PIN# 4645-59-2250 DATE 12/6/01

OWNER OR CONTRACTOR Dienst Enterprises Inc. PHONE: Business Home

ADDRESS 125 Easton Dr. Mooresville NC. 28117

LOCATION 215. TL Alcove TR Templeton TR Templeton Bay TL Katie Spencer on right

SUBDIVISION Templeton Bay BLOCK / SECTION LOT 24 LOT AREA 40,422 sf SITE CLASS. Pgm. #36 DESIGN FLOW 460 gpd L.T.A.R. .3

Septic Tank: 1000 Gallons: STB Date

Pump Tank: 1000 Gallons: PT Date

Pump Make: Model Serial No.

Nitrification Field: No Fields 1 Square Feet 540/810 Linear Feet 270

No Lines 3 Trench Width 24" min Bloc Max Trench Bottom Depth 36"

☑ New System ☐ Repair System Type: I. II. III. (IV) V. VI

System Description: LPP BDS

Repair System Description: SAME

Maintenance Agreement Required: ☑ Yes ☐ No

Gravel Depth N/A ☐ Slab ☑ Crawl Space ☑ Basement w/plumbing ☐ Basement wo/plumbing

☑ House/Mod. Home No. Bedrooms 4

☐ Mobile Home No. Bathrooms 4

☐ Business No. Employees

☐ Other

Water Supply: ☐ Individual ☑ Public ☑ Community


Comments/Conditions: 01-36" MAX TOC

Remove any old barns in septic system area.


Comments/Conditions: (FACTN)

1"=50'

INITIAL SITE SKETCH

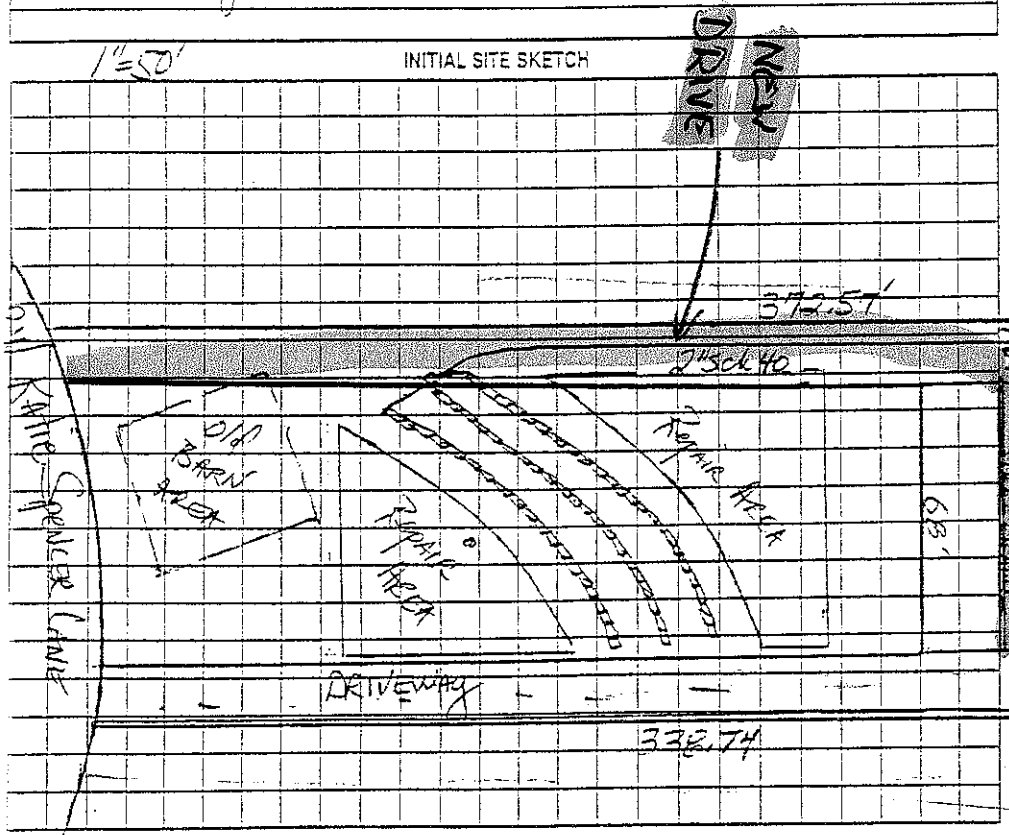

AS BUILT SKETCH

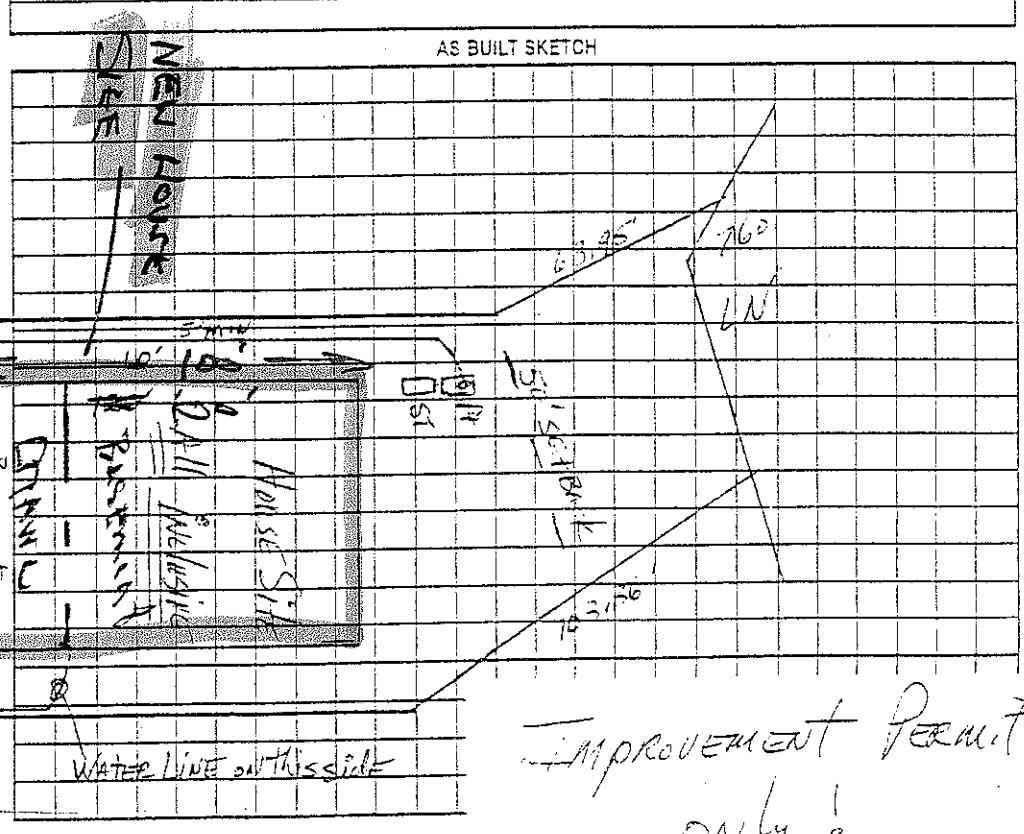

Improvement Permit only!

Do not issue Building Permit

Permit can be suspended or revoked if any false information is supplied toward securing the permit/any unauthorized changes are made to the site/any unauthorized cha

Permit with plat valid without expiration. Improvement Permit with site plan valid for sixty months. Authorization to Construct is valid for a period equal to that of Impro

Signed: Robert B. Dienst date 1/16/02

Improvement Permit by: [signature] date 12-6-01

Installed by:

Operation Permit by:

Existing System Inspection by: