IREDELL COUNTY HEALTH DEPARTMENT

STATESVILLE 704-878-3305 MOORESVILLE 704-664-5281

50.00 Ta. 9 12-60

IMPROVEMENT PERMIT / AUTHORIZATION TO CONSTRUCT / OPERATION PERMIT / EXISTING SYSTEM INSPECTION

PERMIT# Mooresville 225 116331 PIN# ~~4645 57 2250~~ 4645497374.000 DATE 7/16/03

OWNER OR CONTRACTOR St. Lawrence Homes PHONE: Business 892-9700 Home

ADDRESS 7930 W. Kenton Cir. Huntersville NC 28078

LOCATION Alcove, TR Templeton, TR Templeton Bay TL Parkside on Rt

SUBDIVISION Templeton Bay BLOCK / SECTION LOT 25 LOT AREA 0.934C SITE CLASS. PS DESIGN FLOW 600 L.T.A.R. 0.3

Septic Tank: 1500 Gallons; STB 238 Date 6-7-04
Pump Tank: 1500 Gallons; PT 421 Date 6-14-04
Pump Make: Myers Model ME50 Serial No.
Nitrification Field: No Fields 1 Square Feet 1560 Linear Feet 520
No Lines 8 @ 65' Trench Width 36" Max Trench Bottom Depth 36" Gravel Depth —

☒ New System ☐ Repair System Type: I, II, III, IV, V, VI
System Description: Press. Man 25% Red
Repair System Description: LP Panel
Maintenance Agreement Required: ☐ Yes ☒ No

☒ House/Mod. Home No. Bedrooms 5
☐ Mobile Home No. Bathrooms 5
☐ Business No. Employees
☐ Other


☐ Slab ☐ Crawl Space ☒ Basement w/plumbing ☐ Basement wo/plumbing

Water Supply:
☐ Individual
☐ Public
☒ Community


Comments:/Conditions:
1"=60'
5/26/04

Comments:/Conditions: 5/26/04 Builder wants to use Grinder pump to lift sewage to tanks in front Checked tanks & lines 7/16/04 MD

INITIAL SITE SKETCH

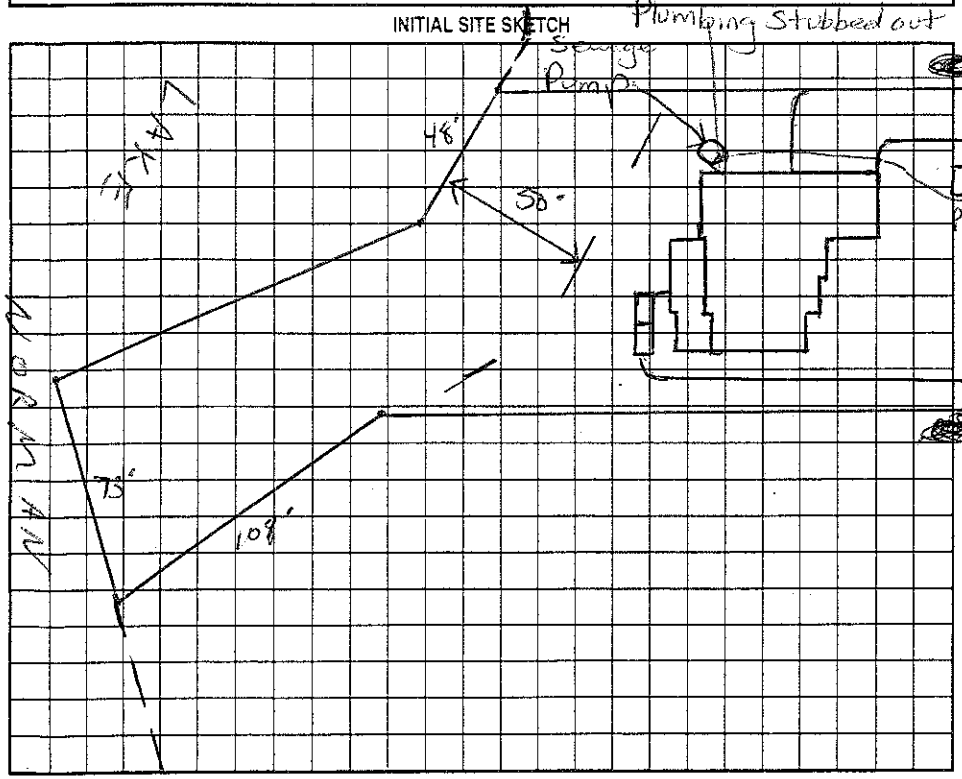

AS BUILT SKETCH

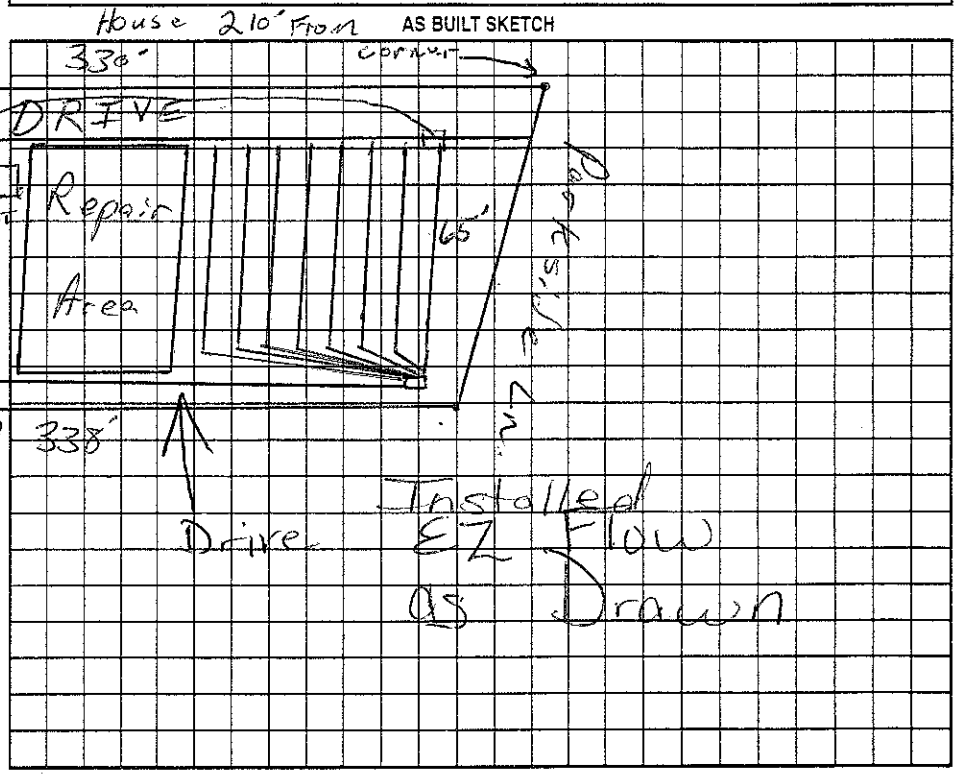

Permit can be suspended or revoked if any false information is supplied toward securing the permit/any unauthorized changes are made to the site/any unauthorized changes are made in the installation of the system. Improvement Permit with plat valid without expiration. Improvement Permit with site plan valid for sixty months. Authorization to Construct is valid for a period equal to that of Improvement Permit not to exceed sixty months.

Signed: [signature] date 11/18/03

Improvement Permit by: [signature] RS date 7/16/03

Authorization to Construct by: [signature] RS date 7/16/03

Installed by: R & T Inc RS

Operation Permit by: Maria Hill Dotson RS date 7/20/04

Existing System Inspection by: date

HEALTH DEPT. COPY: WHITE OWNER COPY (FINAL): YELLOW OWNER COPY (INITIAL): PINK