IREDELL COUNTY HEALTH DEPARTMENT

STATESVILLE 704-878-5305 | MOORESVILLE 704-664-5281

IMPROVEMENT PERMIT / AUTHORIZATION TO CONSTRUCT / OPERATION PERMIT / EXISTING SYSTEM INSPECTION

$45.00 Paid 4:00

PERMIT# Mooresville 225 PIN# ~~4645-59-2250~~ 4645-49-8279 DATE 7/16/03

OWNER OR CONTRACTOR St. Lawrence Homes PHONE: Business 704-892-7700 Home

ADDRESS 7930 W. Kenton Cir Huntersville NC 28078

LOCATION Alcove TR Templeton, TR Templeton Bay, TL Katie Spencer, on Rt

SUBDIVISION Templeton Bay BLOCK / SECTION LOT 26 LOT AREA 0.77AC SITE CLASS. PS DESIGN FLOW 600 L.T.A.R. 0.225-0.25

Septic Tank: 1500 Gallons; STB 338 Date 11/21/03

Pump Tank: 1500 Gallons; PT 421 Date 12/13/03

Pump Make: Myers Model ME50S2 Serial No.

Nitrification Field: No Fields 1 Square Feet 1260 Linear Feet 420

No Lines 6@70' Trench Width 36"-24" Max Trench Bottom Depth 36" Gravel Depth —

☒ New System ☐ Repair System Type: I, II, III, IV, V, VI

System Description: LP Panel Block

Repair System Description: same

Maintenance Agreement Required: ☐ Yes ☐ No

☒ House/Mod. Home ☐ Mobile Home ☐ Business ☐ Other

No. Bedrooms 5 No. Bathrooms 5 No. Employees

Water Supply: ☐ Individual ☐ Public ☒ Community

☐ Slab ☐ Crawl Space ☒ Basement w/plumbing ☐ Basement wo/plumbing


Comments:/Conditions:

Remove any old berms in septic system Area


1"=60'

Comments:/Conditions:

INITIAL SITE SKETCH

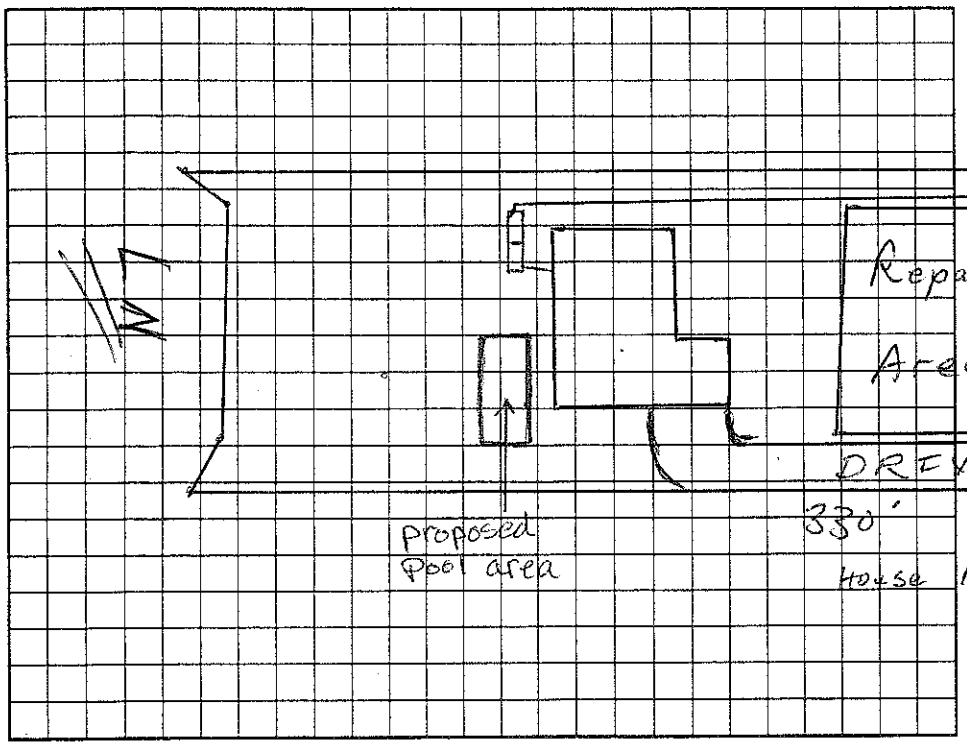

AS BUILT SKETCH

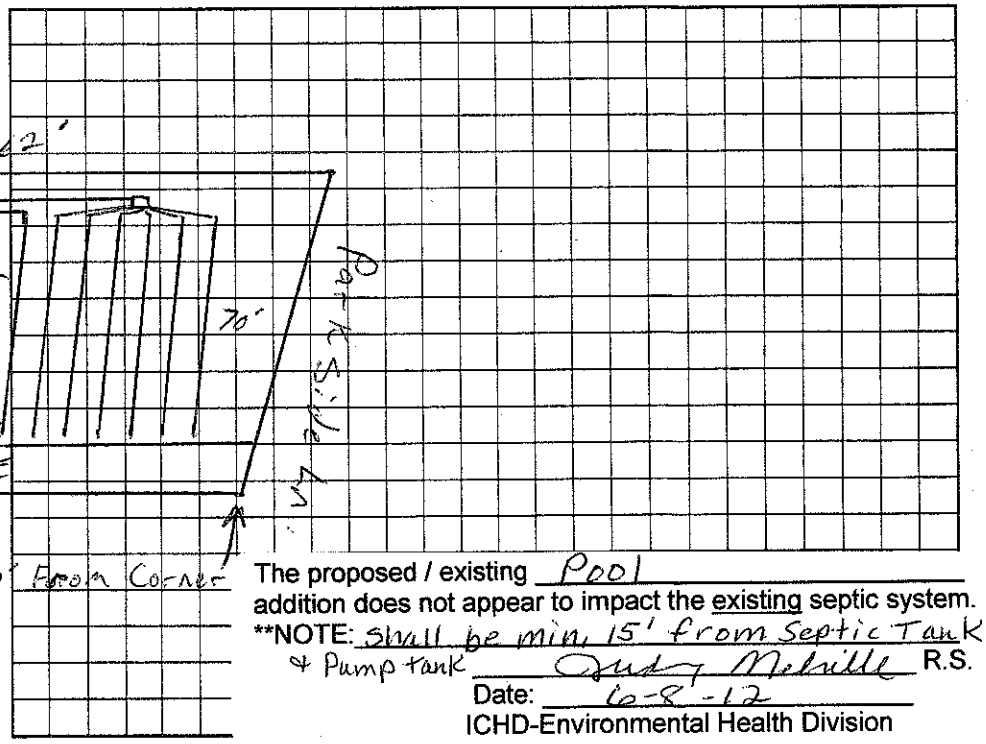

The proposed / existing Pool addition does not appear to impact the existing septic system.

**NOTE: Shall be min. 15' from Septic Tank & Pump tank Cindy Melville R.S.

Date: 6-8-12

ICHD-Environmental Health Division

Permit can be suspended or revoked if any false information is supplied toward securing the permit/any unauthorized changes are made to the site/any unauthorized changes are made in the installation of the system. Improvement Permit with plat valid without expiration. Improvement Permit with site plan valid for sixty months. Authorization to Construct is valid for a period equal to that of Improvement Permit – not to exceed sixty months.

Signed: [signature] date 7/28/03 Installed by: R+H Inc.

Improvement Permit by: [signature] RS date 7/16/03 Operation Permit by: Wesley Sparks R.S. date 1/30/04

Authorization to Construct by: [signature] RS date 7/16/03 Existing System Inspection by: date

HEALTH DEPT. COPY: WHITE OWNER COPY (FINAL): YELLOW OWNER COPY (INITIAL): PINK