106886

IREDELL COUNTY HEALTH DEPARTMENT

STATESVILLE 704-878-5305 MOORESVILLE 704-664-5281

IMPROVEMENT PERMIT / AUTHORIZATION TO CONSTRUCT / OPERATION PERMIT / EXISTING SYSTEM INSPECTI

106886 PERMIT# 225 MRSV1. BIN# 4645-59-2250 4645 49 9279 DATE Dec 11, 01

OWNER OR CONTRACTOR Dienst Enterprises Inc // St. Lawrence Homes PHONE: Business Home

ADDRESS 125 Easton Dr. Mooresville N.C. 28117

LOCATION 215 TL Alcove TR Templeton TR Templeton Bay TL ~~Katie Spencer~~ Parkside Ln on Right #128

SUBDIVISION Templeton Bay BLOCK / SECTION LOT 27 LOT AREA 38,961 ft² SITE CLASS. PS DESIGN FLOW 460 gpd L.T.A.R. .25

Septic Tank: 1000 Gallons; STB 794 Date 8/30/02
Pump Tank: 1000 Gallons; PT 283 Date 8/5/02
Pump Make: Myers Model P102 Serial No.
Nitrification Field: No. Fields 1 Square Feet 1470 Linear Feet 490
No. Lines 7@70' Trench Width 36" Max Trench Bottom Depth 36" Gravel Depth N/A

☑ New System ☐ Repair System Type: I, II, III, IV, V, VI
System Description: PM - Innovative - 25% Red.
Repair System Description: LPP85
Maintenance Agreement Required: ☐ Yes ☑ No initially
☐ Slab ☐ Crawl Space ☑ Basement w/plumbing ☐ Basement wo/plumbing

☑ House/Mod. Home No. Bedrooms 4
☐ Mobile Home No. Bathrooms 4
☐ Business No. Employees
☐ Other


Water Supply: ☐ Individual ~~☐ Public~~ ~~☐ Community~~

Comments:/Conditions:
Remove any old burns in septic system area.


Comments:/Conditions: Note: Soil in trenches was moist, surface was dry.
Checked lines 10/1/02 MD
Checked tanks 10/3/02 MD

1"=50'

INITIAL SITE SKETCH

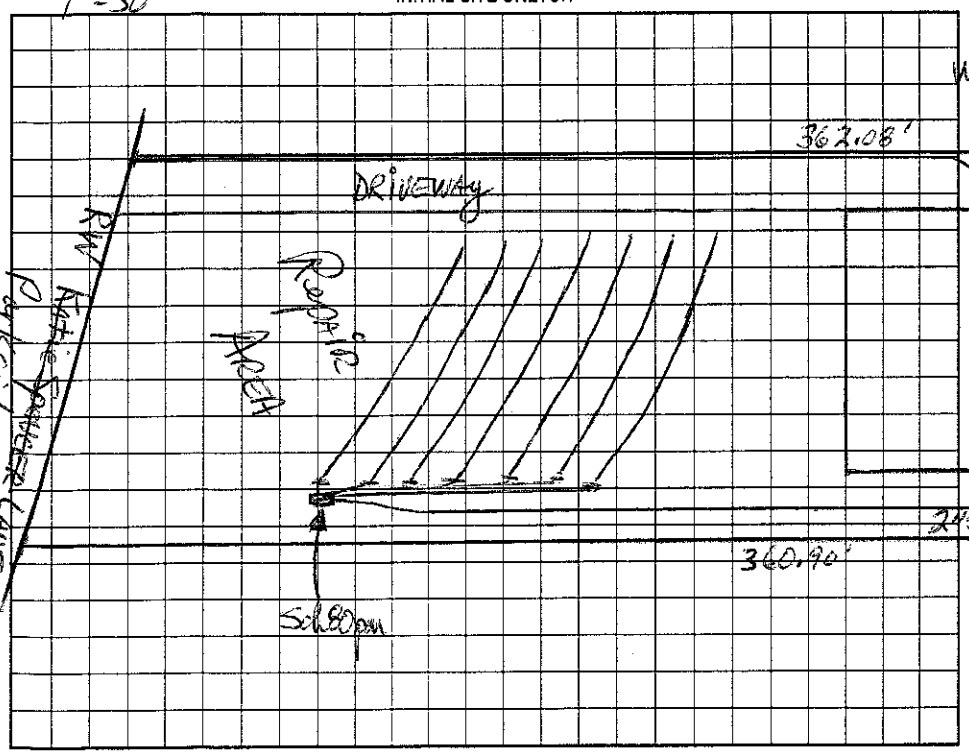

AS BUILT SKETCH

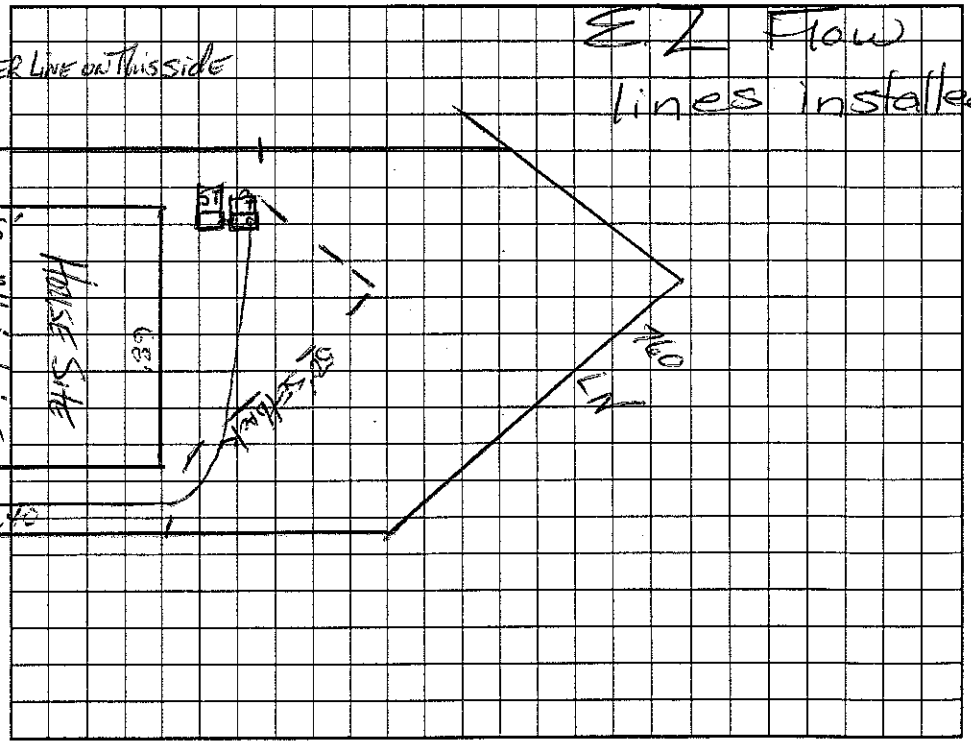

Permit can be suspended or revoked if any false information is supplied toward securing the permit/any unauthorized changes are made to the site/any unauthorized changes are made in the installation of the system. Improvement Permit with plat valid without expiration. Improvement Permit with site plan valid for sixty months. Authorization to Construct is valid for a period equal to that of Improvement Permit – not to exceed sixty months.

Signed: Roberta B. Dienst date 11/16/02 Installed by: R & H Inc RS.

Improvement Permit by: [signature] date 12-11-01 Operation Permit by: Marion H. Dotson date 11/4/2002

Authorization to Construct by: [signature] date 5-23-02 Existing System Inspection by: date

HEALTH DEPT. COPY: WHITE OWNER COPY (FINAL): YELLOW OWNER COPY (INITIAL): PINK