4645545634

IREDELL COUNTY HEALTH DEPARTMENT

STATESVILLE 704-878-5305 MOORESVILLE 704-664-5281

IMPROVEMENT PERMIT / CERTIFICATE OF COMPLETION / OPERATION PERMIT / EXISTING SYSTEM INSPECTION

PROPERTY DESCRIPTION NO. 12417 DATE 6/3/94 TAX MAP NO. 2H-A-78 Watershed: ☐ Yes ☑ No

OWNER OR CONTRACTOR Jerry W. Keller PHONE: Business 663-1524 Home

ADDRESS Wades Way Mooresville, NC. 28115

LOCATION Wades Way; Alcove Rd, TL ON GRAVEL AFTER PERRINOR, X creek to 1st lot on (R)

SUBDIVISION N/A BLOCK / SECTION LOT N/A LOT AREA .5 AC SITE CLASS. P DESIGN FLOW 360 L.T.A.R. .4

Septic Tank: 1000 Gallons; STB 794 Date 4/22/94
Pump Tank: Gallons; PT Date
Pump Make: Model Serial No.
Nitrification Field: No Fields 1 Square Feet 900 Linear Feet 300
No Lines 3 Trench Width 3' Max Trench Bottom Depth 36" Gravel Depth 12"

☑ New System ☐ Repair System Type: I ☐ II, III, IV, V, VI
System Description: DROP BOX - CONV.
Repair System Description: PRESSURE PANEL
Maintenance Agreement Required: ☐ Yes ☑ No


☑ House/Mod. Home No. Bedrooms 3
☐ Mobile Home No. Bathrooms 2
☐ Business No. Employees
☐ Other
☐ Slab ☑ Crawl Space ☐ Basement w/plumbing ☐ Basement wo/plumbing

Water Supply: ☑ Individual ☐ Community ☐ Public

Comments:

Comments:

~~INITIAL SITE SKETCH~~ AS BUILT

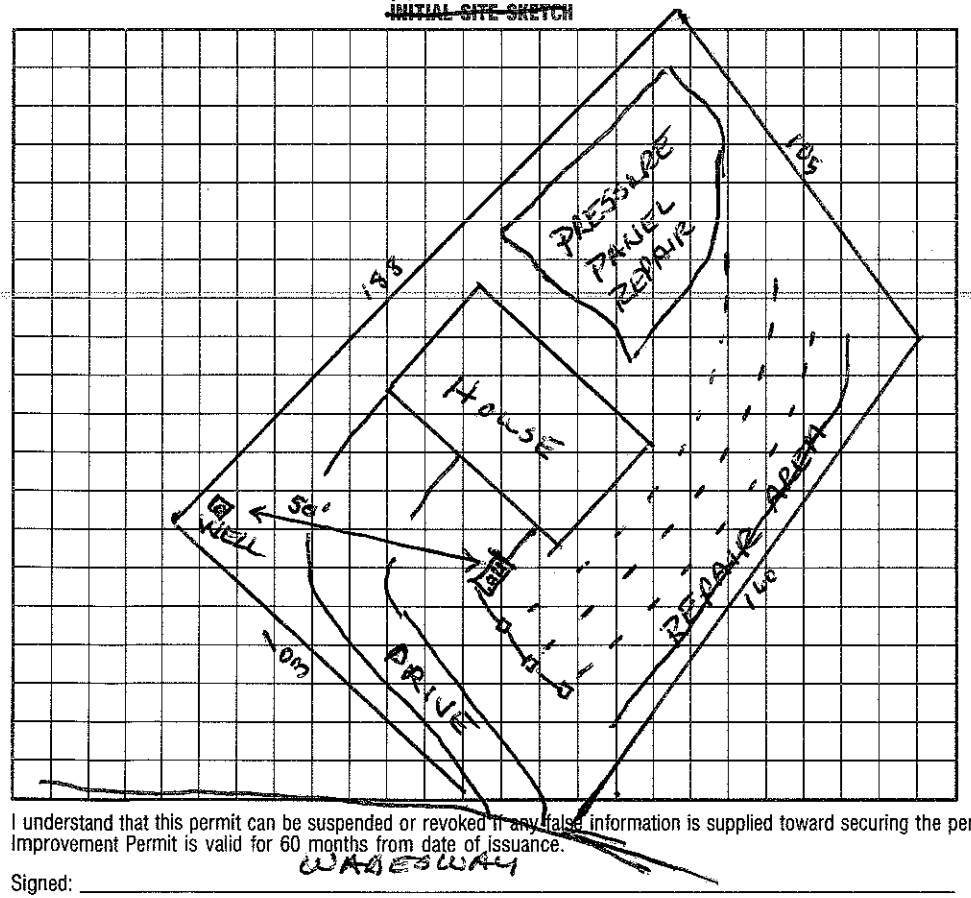

AS BUILT SKETCH

I understand that this permit can be suspended or revoked if any false information is supplied toward securing the permit/any unauthorized changes are made to the site/any unauthorized changes are made in the installation of the system. Improvement Permit is valid for 60 months from date of issuance.

WADESWAY

Signed:

Improvement Permit by: date

Existing System Inspection by: date

Installed by: FJ Ewen

Certificate of Completion by: Wesley Sparks date 6/3/94

Operation Permit by: date

HEALTH DEPT. COPY: WHITE INSPECTION COPY (FINAL): GREEN OWNER COPY (FINAL): YELLOW INSPECTION COPY (INITIAL): PINK OWNER COPY (INITIAL): GOLD