IREDELL COUNTY HEALTH DEPARTMENT - *ENVIRONMENTAL HEALTH* ☐ STATESVILLE OFFICE 704-878-5305 ☒ MOORESVILLE OFFICE 704-664-5281

IMPROVEMENT PERMIT / AUTHORIZATION TO CONSTRUCT / OPERATION PERMIT / EXISTING SYSTEM INSPECTION

PERMIT # REPAIR PIN # 4645-56-3141 DATE 3-14-12

OWNER DENNIS & PATRICIA HOWE APPLICANT: RUSSELL WILLIAMS PHONE: Home/Cell # 980-429-1580 Business #

SITE ADDRESS 157 PERRIN DR. OWNER / APPLICANT ADDRESS 18747 MAINSALE POINT DR. CORNELIUS

SITE DIRECTIONS ALCOVE TO PERRIN, ON L

SUBDIVISION WATERS EDGE BLOCK / SECTION LOT # 7A LOT AREA .98 AC DESIGN FLOW 360 L.T.A.R. .25

Septic Tank Ex. 1000 Gallons: STB Date

Pump Tank Gallons: P T Date

Pump Make Model Serial #

No. Nitrification Fields: 1 No. Lines Linear Feet 60'

Trench Width 10' Max. Trench Bottom Depth 36" Gravel Depth —

☐ New System ☒ Repair ☐ Expansion System Type I II (III) IV V VI

System Description:

Repair System Description: 10'X60' RED

Maintenance Agreement Required ☐ YES ☒ NO

☒ GRAVITY ☐ PRESSURE

☒ Residence No. Bedrooms 3

☐ Business No. Persons

☐ Other No. Employees


☐ Slab ☒ Crawl Space

☐ Basement w/plumbing ☐ Basement w/o plumbing


Water Supply: ☒ Private ☐ Public ☐ Community

Comments / Conditions ① FEED NEW RED FIRST ② USE SPEED LEVELERS IN D-BOX

INITIAL SITE SKETCH

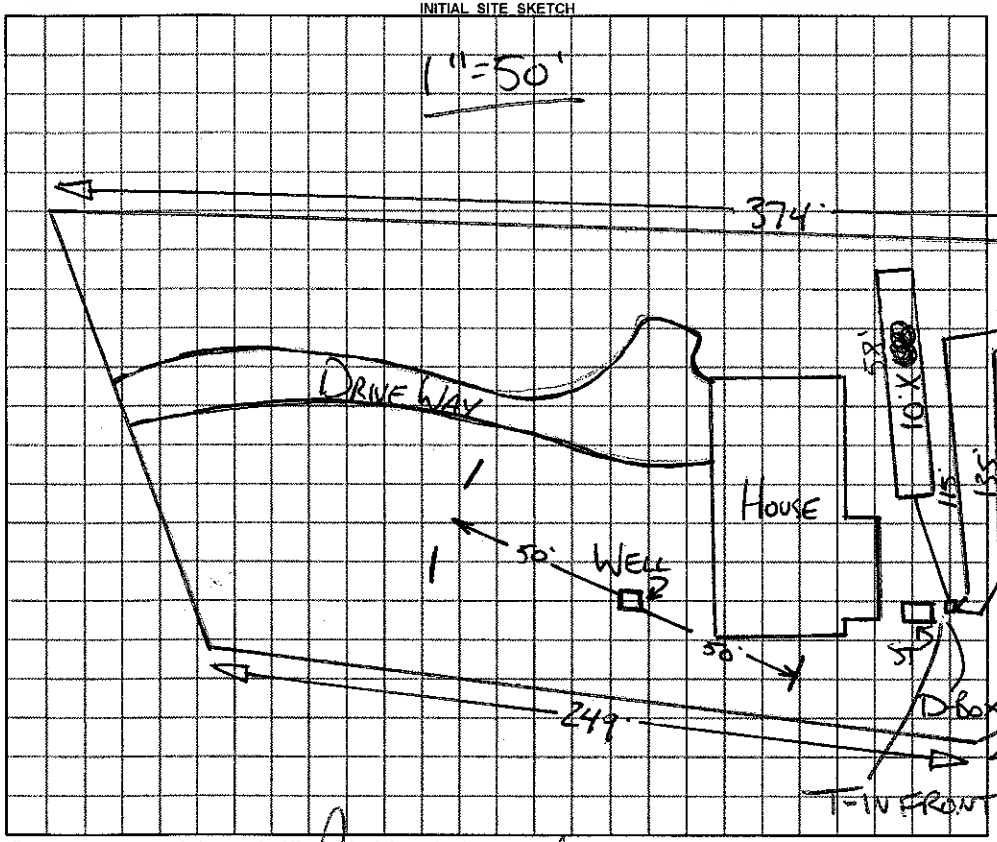

AS BUILT SKETCH

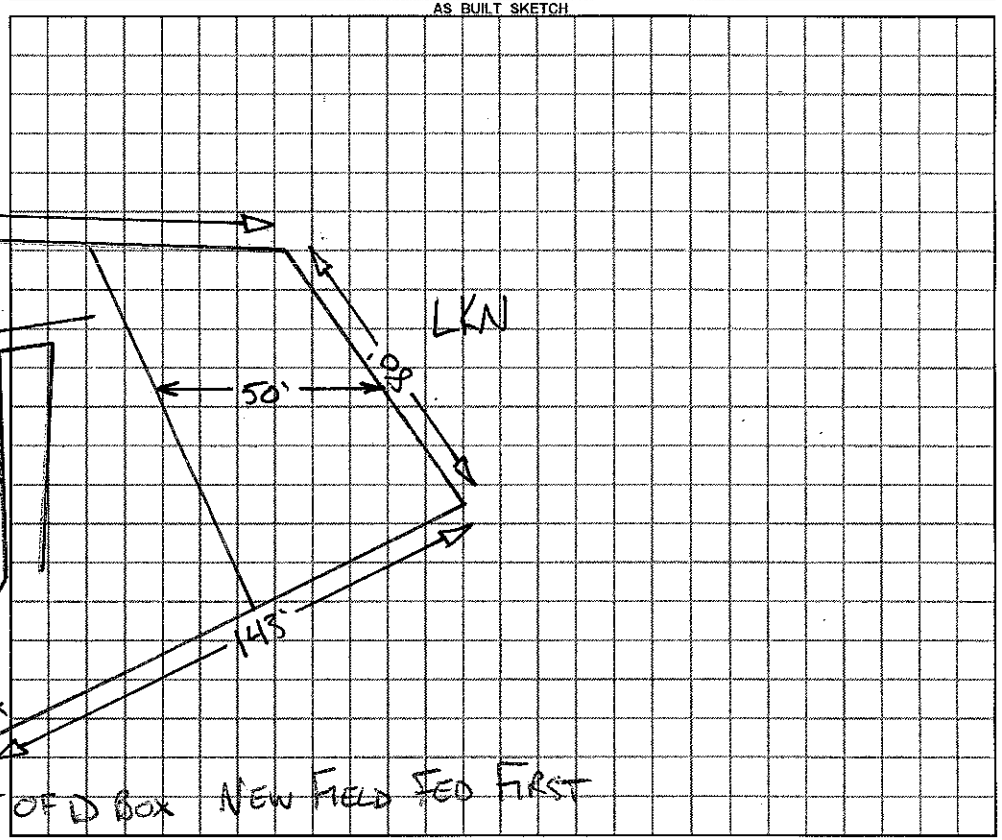

Permit can be suspended or revoked if any false information is supplied toward securing the permit / any unauthorized changes are made to the site / any unauthorized changes are made in the installation of the system.

☐ ***IMPROVEMENT PERMIT*** with plat valid without expiration. ☐ ***IMPROVEMENT PERMIT*** with plat valid without expiration. ***site plan valid 60 mo.*** ☒ ***AUTHORIZATION TO CONSTRUCT*** valid for period equal to IMPROVEMENT PERMIT--not to exceed 60 mo.

Owner / Applicant Signature: Date 4-2-12 Installed by: WASTE WATER S.O.L.

IMPROVEMENT PERMIT by: REHS Date 3-14-12 OPERATION PERMIT by: REHS Date 4-19-12

AUTHORIZATION TO CONSTRUCT by: REHS Date 3-14-12 Existing System Inspected by: REHS Date

YOU SHOULD CONTACT A LOCATOR SERVICE PRIOR TO ANY EXCAVATION

White Copy -- Environmental Health YELLOW COPY (Final) Owner / Applicant PINK COPY (Initial) Owner / Applicant