IREDELL COUNTY HEATLH DEPARTMENT

PAGE 2: *SITE PLAN WORKSHEET*

SEE THE SAMPLE SITE PLAN BELOW. INCOMPLETE SITE PLANS WILL BE RETURNED TO YOU FOR COMPLETION AND MAY RESULT IN A DELAY IN THE ISSUANCE OF YOUR SEPTIC SYSTEM PERMIT!!!

Place an (X) beside each item as you complete the site plan:

- ✓ Property Line measurements are clearly identified…
- ✓ All proposed structures are indicated…
- *SHOW: proposed house or business footprint, wells, water lines, patios, pools and decks, and any other item that will occupy space on the site*
- ✓ Front and side setbacks from property line…
- ✓ Preferred driveway location and configuration, preferred well location…
- ✓ Area you prefer your septic system to be placed…
- ✓ North arrow, or other sufficient indicator of direction…

Circle N/A on the following if appropriate:


- ✓ Location of septic systems and wells within 100' of your property… N/A
- ✓ Location of easements and rights of ways on your property… N/A
- Location of any designated wetlands on the property… N/A

Signature: Russell Williams for Patty Howe
Property owner or owner's legal representative signature (SIGNATURE REQUIRED)

3-1-12
DATE

USE THIS SPACE TO DRAW YOUR SITE PLAN


See Attached.

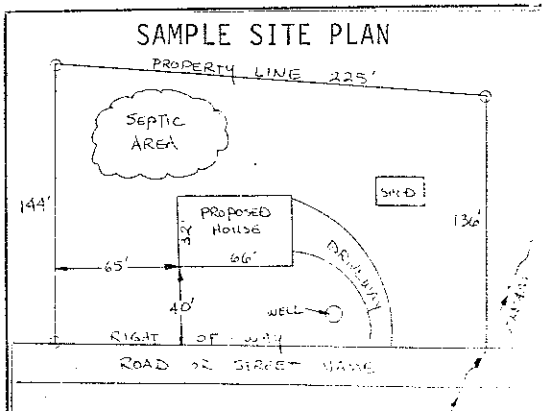

Septic System Site Plan (As Built) for 157, Perrin Dr Mooresville, NC

CONNECTGIS WEB HOSTING IREDELL COUNTY NORTH CAROLINA

The maps prepared for this website are generated from recorded deeds, plats, and other public records. Users of these maps are hereby notified that the information provided herein should be verified. Iredell County assumes no legal responsibilities for any of the information contained on this site. Users are advised that the use of any of this information is at their own risk. All maps on this site were prepared using a 1000â€™ Grid based upon the North Carolina State Plane Coordinate System from the 1983 North American Datum. The delinquent real property tax overlay is updated monthly. The information presented is not intended to be used or relied upon as official notice of tax liens. For additional information regarding delinquent taxes, contact the Iredell County Tax Collector's Office.

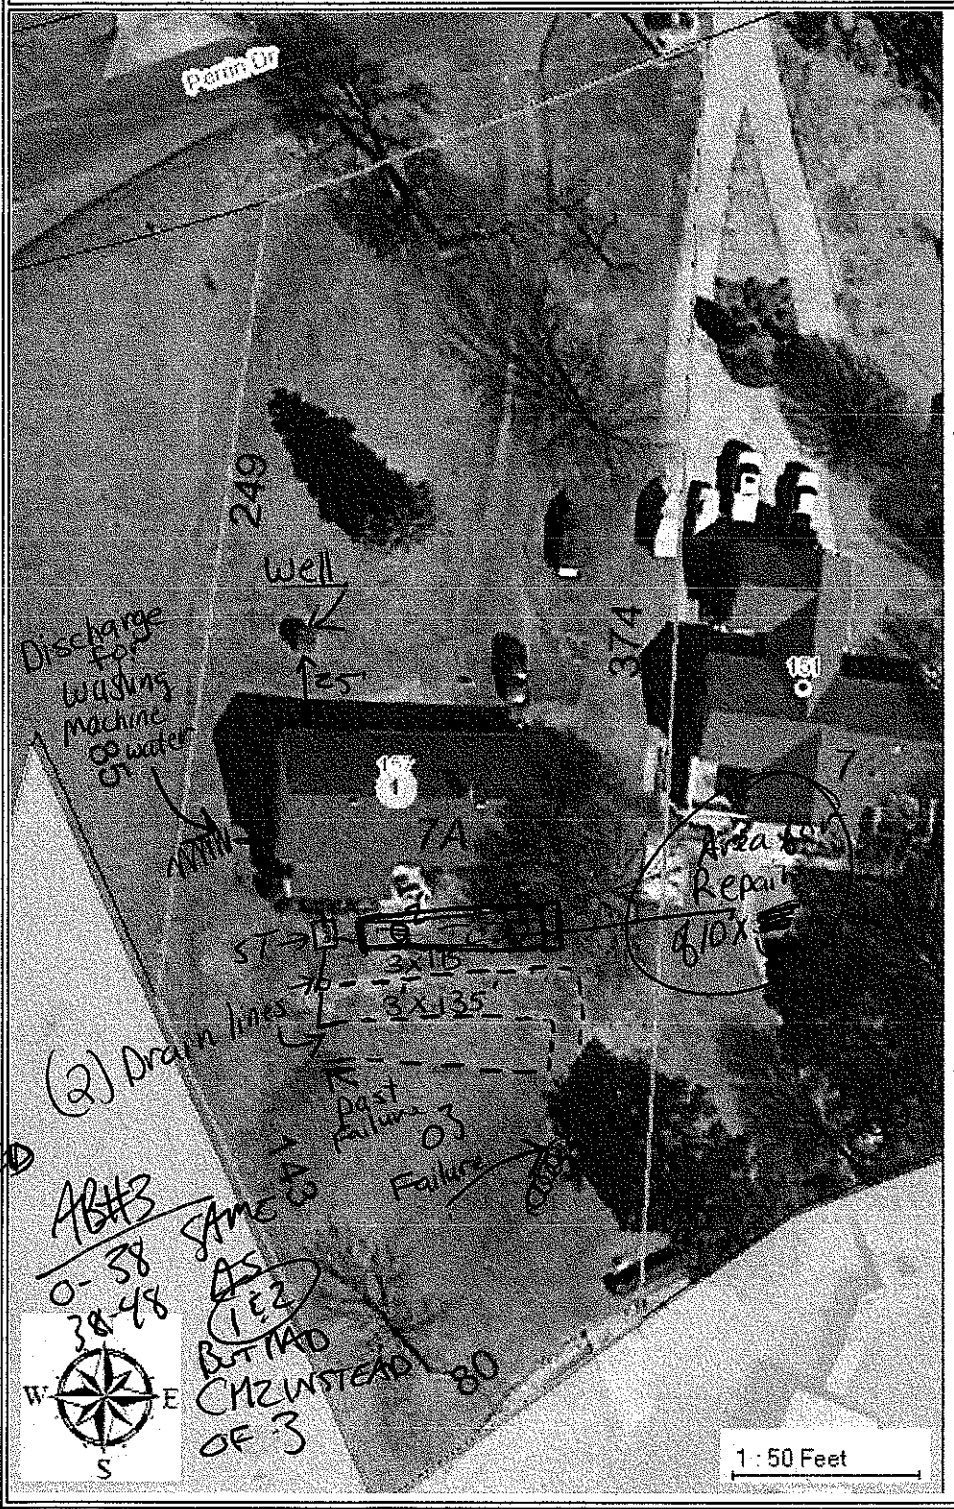

* Discharge for washing machine & water softener

Feed

AB#1
0-44 SC/CL MSBK SS
44-48 CMSBK CH3 Y/BR

(25)

1440 2160
+ 720

AB#2 0-42 SC/CL MSBK SS
42-48 CMSBK CH3 Y/BR CH3