ICHD - ENVIRONMENTAL HEALTH DIVISION

SB

Statesville Office (704) 878-5305 | Mooresville Office (704) 660-3625

OSWP

PERMIT # 2023 - 31995

SEPTIC: IMPROVEMENT PERMIT / AUTHORIZATION TO CONSTRUCT / OPERATION PERMIT / EXISTING SYSTEM

PIN # 4645 -- 56 -- 4834

APPLICANT/OWNER: Jeanie Lentz

APPLICANT ADDRESS: 463 Lentz Rd, Statesville 28625

SITE ADDRESS: 150 Edgeway Rd, Mooresville 28117

PHONE: 980-829-3278

ALT. PHONE

SITE DIRECTIONS: Alcove Rd - (R) Edgeway - Lot on (R)

SAP CONTROLLED: ☐ YES ☐ NO

SUBDIVISION:

SECTION: — LOT # — LOT AREA: 1 acre


DESIGN FLOW: Ex. L.T.A.R.: Ex.

Septic Tank	1000	(gal)	STB	7152	Date	INFILTRATOR	☐ New System	☑ Repair	☐ Expansion	System Type: I (II) III IV V VI	
Pump Tank		(gal)	PT		Date		System Description:				
Pump Make		Model			Serial #		Repair System Description:	Tank Replacement			
# Nitrification Fields	Ex	# Lines	Ex.		Linear Ft	Ex.	Maintenance Agreement Required:	☐ YES	☐ NO		
Trench Width	Ex.	Trench Bottom Depth(Low side)		Ex.	Gravel Depth			☐ GRAVITY	☐ PRESSURE		

☑ Residence	No. Bedrooms	Ex.	Water Supply
☐ Business	No. Persons	Ex.	☑ Private
☐ Other	No. Employees		☐ Public
☐ Slab	☑ Crawl Space		☐ Community
☐ Basement w/plumbing	☐ Basement w/o plumbing		

Comments / Conditions: Pump, crush, fill old tank. Replace distribution if necessary. Keep new tank 10' from house & 5' off porch.

INITIAL SITE SKETCH

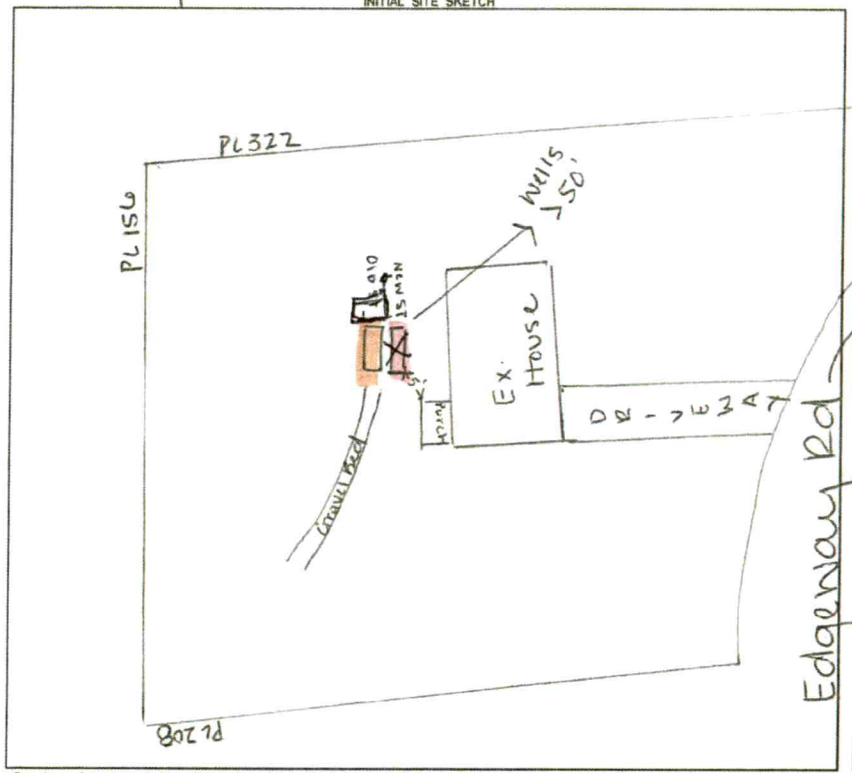

AS BUILT SKETCH

FOR SEPTIC FINAL INSPECTION CALL: 704-664-3703 between 8am-9am the day the inspection is needed. Be sure to speak with an inspector to confirm your time.



Permit can be suspended or revoked if any false information is supplied toward securing the permit / any unauthorized changes are made to the site / any unauthorized changes are made in the installation of the system. **CONTACT A LOCATOR SERVICE PRIOR TO ANY EXCAVATION**

☐ **IMPROVEMENT PERMIT** *with plat valid without expiration.* ☑ **IMPROVEMENT PERMIT** *with site plan valid for 60 mos.* ☑ **AUTHORIZATION TO CONSTRUCT** *valid for period equal to IMPROVEMENT PERMIT--not to exceed 60 mo.*

Owner / Applicant Signature: online Date:

Installed by: LENTZ WASTEWATER

IMPROVEMENT PERMIT by: Sydney Holland Date: 8/1/23

OPERATION PERMIT by: Bryant L. White Date:

AUTHORIZATION TO CONSTRUCT by: Sydney Holland Date: 8/1/23

Existing System Inspected by: Date:

FOR SEPTIC FINAL INSPECTION: CALL 704-664-3703 between 8am-9am the day the inspection is needed..