IREDELL COUNTY HEALTH DEPARTMENT

Statesville Office (704) 878-5305 Mooresville Office (704) 660-3625 PERMIT # 202131

IMPROVEMENT PERMIT / AUTHORIZATION TO CONSTRUCT / OPERATION PERMIT / EXISTING SYSTEM

PIN # 4645-56-6570

APPLICANT: Chris Supple APPLICANT ADDRESS: 136 Perrin Dr Mooresville NC 28117

SITE ADDRESS: 136 Perrin Dr Mooresville NC 28117 PHONE: 704-400-1182 ALT. PHONE:

SITE DIRECTIONS: Hwy 21 S, TL on Alcove Rd, TR on Perrin Dr, Lot on R

SUBDIVISION: Waters Edge SECTION: LOT # 9 LOT AREA: DESIGN FLOW: 360gal L.T.A.R.:

Septic Tank EXISTING (gal) STB Date
Pump Tank (gal) PT Date
Pump Make Model Serial #
Nitrification Fields # Lines Linear Ft:
Trench Width Max. Trench Bottom Depth Gravel Depth

☐ New System ☐ Repair ☐ Expansion System Type: I II III IV V VI
System Description: EXISTING
Repair System Description:
Maintenance Agreement Required: ☐ YES ☐ NO
☐ GRAVITY ☐ PRESSURE


☑ Residence No. Bedrooms 3
☐ Business No. Persons 6
☐ Other No. Employees
☐ Slab ☐ Crawl Space
☐ Basement w/plumbing ☐ Basement w/o plumbing

Water Supply
☑ Private
☐ Public
☐ Community

Comments / Conditions:

INITIAL SITE SKETCH

AS BUILT SKETCH

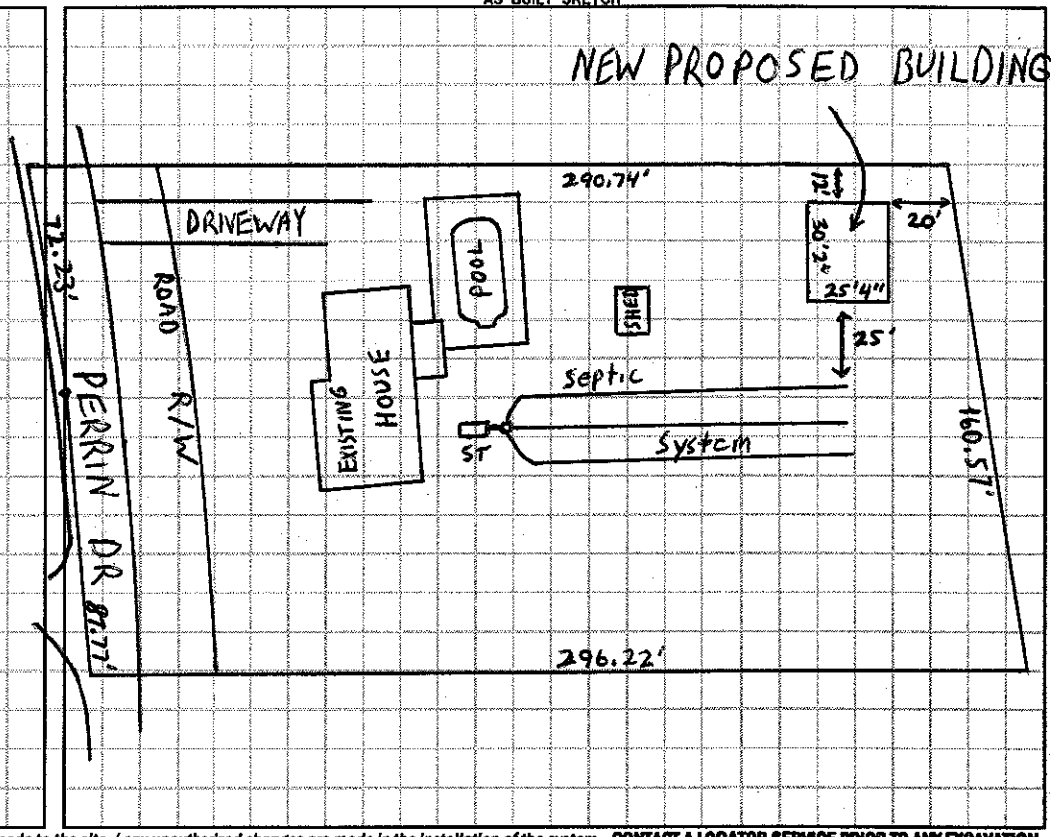

Permit can be suspended or revoked if any false information is supplied toward securing the permit / any unauthorized changes are made to the site / any unauthorized changes are made in the installation of the system. **CONTACT A LOCATOR SERVICE PRIOR TO ANY EXCAVATION**

☐ **IMPROVEMENT PERMIT** ***with plat*** *valid without expiration.* ☐ **IMPROVEMENT PERMIT** ***with site plan*** *valid for 60 mos.* ☐ **AUTHORIZATION TO CONSTRUCT** *valid for period equal to IMPROVEMENT PERMIT--not to exceed 60 mo.*

Owner / Applicant Signature: Date: Installed by:

IMPROVEMENT PERMIT by: Date: OPERATION PERMIT by: Date:

AUTHORIZATION TO CONSTRUCT by: Date: Existing System Inspected by: Date: 3-18-14

Health Dept. Copy - WHITE Applicant (Final Approval) - YELLOW Applicant (Conditional Approval) - PINK