118297 H75 3/20

IREDELL COUNTY HEALTH DEPARTMENT

STATESVILLE 704-878-5305 MOORESVILLE 704-664-5281

IMPROVEMENT PERMIT / AUTHORIZATION TO CONSTRUCT / OPERATION PERMIT / EXISTING SYSTEM INSPECTION

PERMIT# 225 Resid. PIN# ~~4645-59-2250~~ 4645-58-2625 DATE Nov. 19, 01

OWNER OR CONTRACTOR Diesel Enterprises Inc. / St. Lawrence Homes PHONE: Business _____ Home _____

ADDRESS 125 Easton Dr. Mooresville NC

LOCATION 21S TL Alcove TR Templeton TR Templeton Bay TL Greenfield on left

SUBDIVISION Templeton Bay BLOCK / SECTION _____ LOT 3 LOT AREA 24,042 ft² SITE CLASS. RS per 1956 DESIGN FLOW 480gpd L.T.A.R. .03

Septic Tank: 1000 Gallons; STB 794 Date 3-22-04
Pump Tank: 1000 Gallons; PT 283 Date 4-14-04
Pump Make: Goulds Model WE0312M Serial No. CO465826
Nitrification Field: No Fields 1 Square Feet 540/810 Linear Feet 270
No Lines 3 Trench Width 24" min 30" max Max Trench Bottom Depth 36" Gravel Depth NA

☑ New System ☐ Repair System Type: I, II, III, IV, V, VI
System Description: LP PABRS
Repair System Description: SAME
Maintenance Agreement Required: ☑ Yes ☐ No

☑ House/Mod. Home No. Bedrooms 4
☐ Mobile Home No. Bathrooms 4
☐ Business No. Employees ____
☐ Other _____

☐ Slab ☑ Crawl Space ☐ Basement w/plumbing ☐ Basement wo/plumbing


Water Supply: ☐ Individual ☑ Public ☐ Community

Comments/Conditions: Do not cut house site, Backfill only against foundation to provide positive drainage. Remove any old burn in Septic System area

Comments/Conditions: Tank & lines checked 5/25/04
Checked pressure, elect & alarm Cd 3/04

1"=50'

INITIAL SITE SKETCH

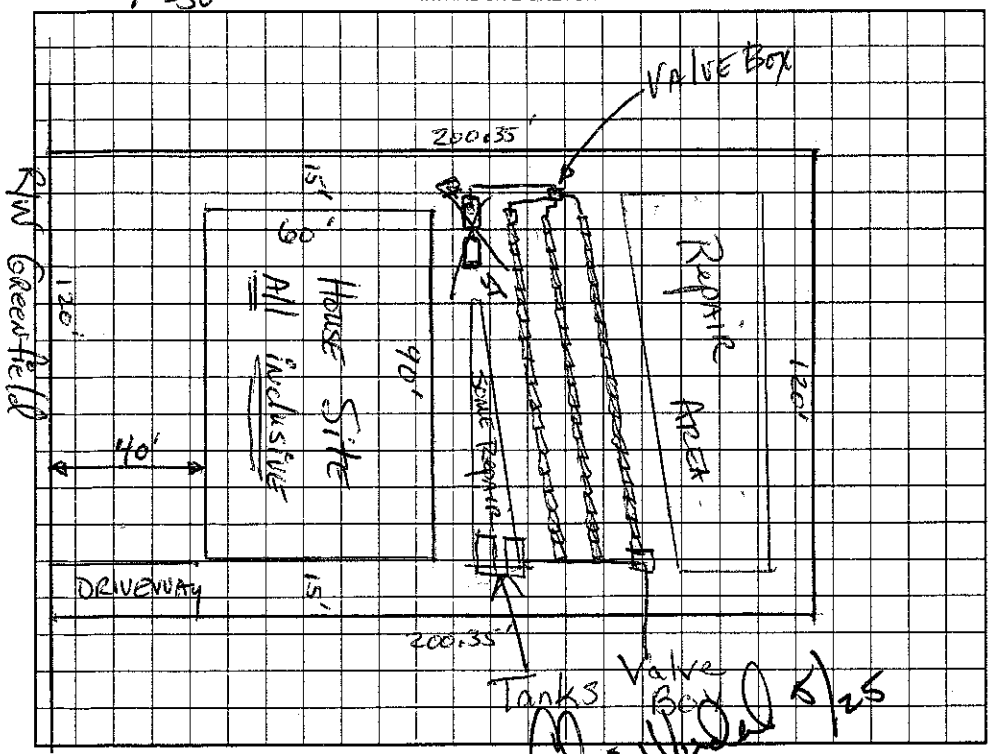

AS BUILT SKETCH

Permit can be suspended or revoked if any false information is supplied toward securing the permit/any unauthorized changes are made to the site/any unauthorized changes are made in the installation of the system. Improvement Permit with plat valid without expiration. Improvement Permit with site plan valid for sixty months. Authorization to Construct is valid for a period equal to that of Improvement Permit – not to exceed sixty months.

Signed: Robert B. Diesel date 11/16/02
Improvement Permit by: Mark Thompson RS date 11-19-01
Authorization to Construct by: [signature] RS date 2/10/04

Installed by: R & H
Operation Permit by: Jamie H. Dobson R.S. date 6/3/04
Existing System Inspection by: _____ date _____

HEALTH DEPT. COPY: WHITE OWNER COPY (FINAL): YELLOW OWNER COPY (INITIAL): PINK