Permit # 106 888

IREDELL COUNTY HEALTH DEPARTMENT

STATESVILLE 704-878-5305 MOORESVILLE 704-664-5281

IMPROVEMENT PERMIT / AUTHORIZATION TO CONSTRUCT / OPERATION PERMIT / EXISTING SYSTEM INSPECTION

PERMIT# 225 MRS#1. PIN# ~~4645-59-2258~~ 4645-58-3631 DATE Nov. 19, 01

OWNER OR CONTRACTOR Dienst Enterprises Inc. / St. Lawrence Homes PHONE: Business 309-0823 Home

ADDRESS 125 Easton Dr. Mooresville N.C. 28117

LOCATION 215 TL Alcove TR Templeton TR Templeton Bay TL Greenfield 2nd on left

SUBDIVISION Templeton Bay BLOCK / SECTION LOT 2 LOT AREA 24,042 sf SITE CLASS. 1 & 1556 DESIGN FLOW 480 gpd L.T.A.R. e3

Septic Tank: 1000 Gallons; STB 794 Date 5/14/02

Pump Tank: 1000 Gallons; PT 283 Date 7/31/02

Pump Make: Myers Model ME33 Serial No.

Nitrification Field: No Fields 1 Square Feet 540/810 Linear Feet 270

No Lines 3 Trench Width 24" MIN 36" MAX Max Trench Bottom Depth 36"

☑ New System ☐ Repair System Type: I, II, III, IV, V, VI

System Description: LP PPBRS

Repair System Description: SAME

Maintenance Agreement Required: ☑ Yes ☐ No

Gravel Depth NA

☑ House/Mod. Home No. Bedrooms 4

☐ Mobile Home No. Bathrooms 4

☐ Business No. Employees

☐ Other

☐ Slab ☑ Crawl Space ☐ Basement w/plumbing ☐ Basement wo/plumbing

Water Supply: ☐ Individual ☑ Public ☑ Community


Comments/Conditions: Do not cut house site. Backfill only against foundation to provide positive drainage. Remove any old burn in septic system area.

Comments/Conditions: Tanks & lines Checked by GM 8/23/02

Pres, Elect & Alarm by MD 9/18/02

INITIAL SITE SKETCH

1"=50'

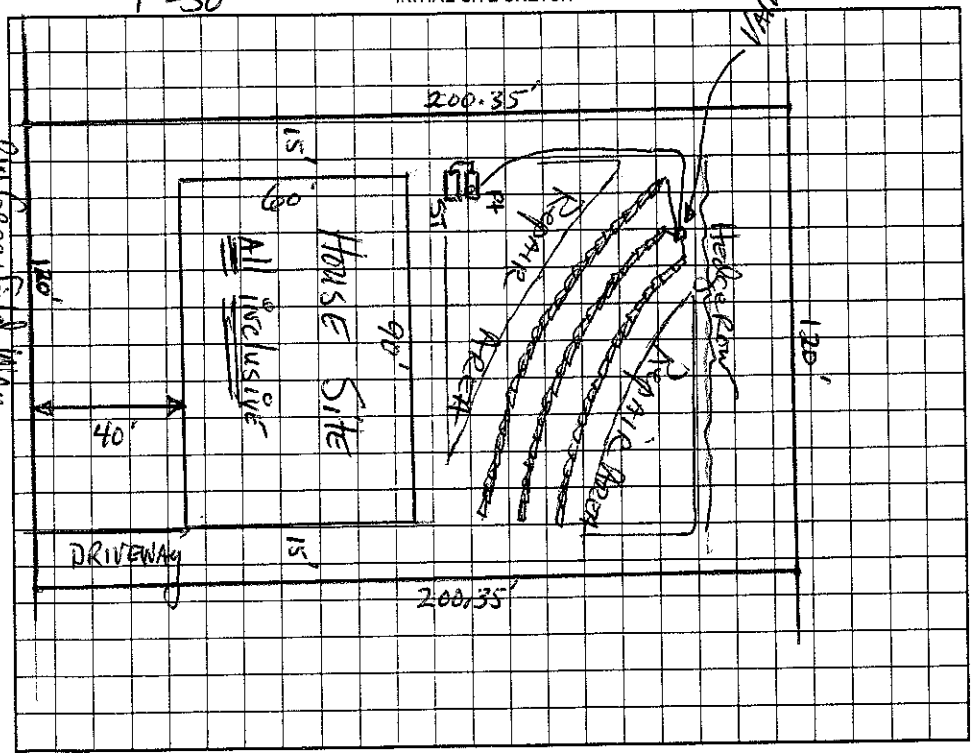

AS BUILT SKETCH

Permit can be suspended or revoked if any false information is supplied toward securing the permit/any unauthorized changes are made to the site/any unauthorized changes are made in the installation of the system. Improvement Permit with plat valid without expiration. Improvement Permit with site plan valid for sixty months. Authorization to Construct is valid for a period equal to that of Improvement Permit – not to exceed sixty months.

Signed: Robert Dienst date 11/16/02

Improvement Permit by: [signature] date 11-19-01

Authorization to Construct by: [signature] RS date 5/23/02

Installed by: Robert Dienst RS

Operation Permit by: Maria H. Dotson date 9/18/2002

Existing System Inspection by: date

HEALTH DEPT. COPY: WHITE OWNER COPY (FINAL): YELLOW OWNER COPY (INITIAL): PINK