IREDELL COUNTY HEALTH DEPARTMENT

4645-58-3896

STATESVILLE 704-878-5305 — MOORESVILLE 704-664-5281

IMPROVEMENT PERMIT / AUTHORIZATION TO CONSTRUCT / OPERATION PERMIT / EXISTING SYSTEM INSPECTION

PERMIT# ~~225~~ 128900 PIN# ~~4645-59-2250~~ Deran DATE 5-20-04

OWNER OR CONTRACTOR St. Lawrence Homes PHONE: Business 892-7700 Home 201-9297 Chris

ADDRESS

LOCATION Hwy 21 S TL Alcove TR Templeton TR Templeton Bay TL Huntfield Way 2nd on rgt

SUBDIVISION Templeton Bay BLOCK / SECTION LOT 21 LOT AREA .606 Acre SITE CLASS PS DESIGN FLOW 480 gpd L.T.A.R. .3

Septic Tank: 1000 Gallons; STB 794 Date 7-26-05
Pump Tank: 1000 Gallons; P.T. 27 Date 8-7-05
Pump Make: Goulds Model WE0312MV Serial No.
Nitrification Field: No Fields 1 Square Feet 540 Linear Feet 270
No Lines 3@90' Trench Width 24" Max Trench Bottom Depth 36" Gravel Depth N/A

☒ New System ☐ Repair System Type: I, II, III, IV, V, VI
System Description: Pump-LP-Panel Block
Repair System Description: Same
Maintenance Agreement Required: ☒ Yes ☐ No


☒ House/Mod. Home No. Bedrooms 4
☐ Mobile Home No. Bathrooms 4
☐ Business No. Employees
☐ Other
☐ Slab ☒ Crawl Space ☐ Basement w/plumbing ☐ Basement wo/plumbing

Water Supply: ☐ Individual ☒ Public ☐ Community

Comments/Conditions: Do not cut house site. Remove any old burms in Septic System area. Maintain 15' minimum from outside of storm drain to closest point of Septic System.

Comments/Conditions: Future pool 18'x32' must stay within pool foot print indicated on drawing; 15' from Septic System.

INITIAL SITE SKETCH

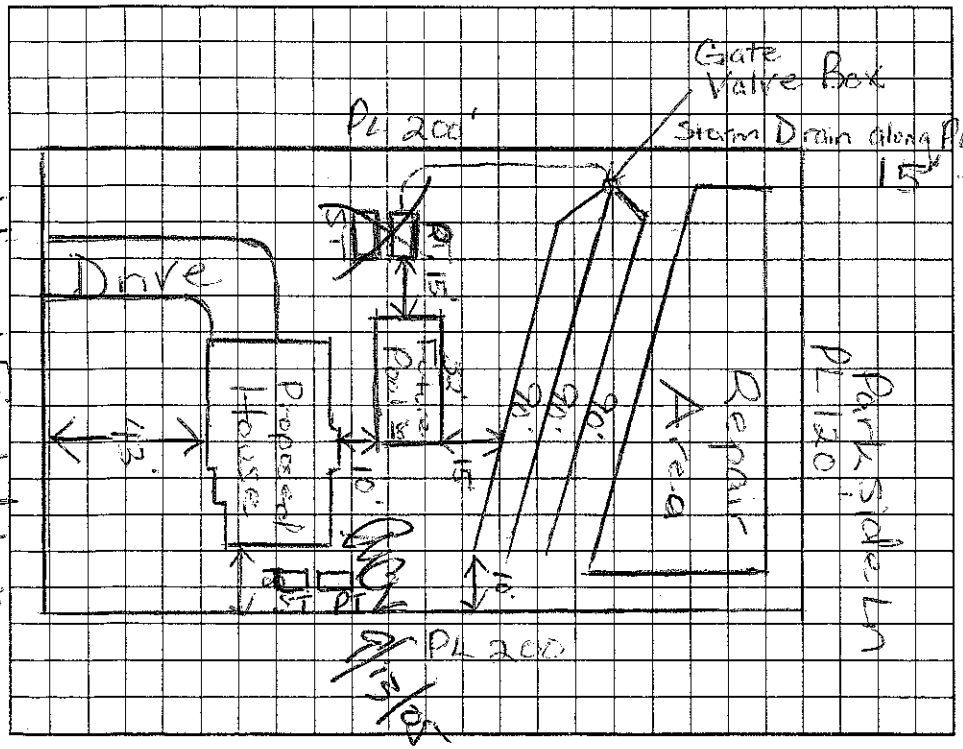

AS BUILT SKETCH

Checked tanks & lines 9/13/05
Pressure elect & alarm 9/16/05
Agreement attached.
Stay at least
for setback

Permit can be suspended or revoked if any false information is supplied toward securing the permit/any unauthorized changes are made to the site/any unauthorized changes are made in the installation of the system. Improvement Permit with plat valid without expiration. Improvement Permit with site plan valid for sixty months. Authorization to Construct is valid for a period equal to that of Improvement Permit – not to exceed sixty months.

Signed: Durand Koch date 5-25-05 Installed by: Ralph RS

Improvement Permit by: Maina M. Kahan RS date 5/20/05 Operation Permit by: Maina M. Kahan date 9/16/05

Authorization to Construct by: Maina M. Kahan RS date 5/20/05 Existing System Inspection by: date

HEALTH DEPT. COPY: WHITE OWNER COPY (FINAL): YELLOW OWNER COPY (INITIAL): PINK