122427

IREDELL COUNTY HEALTH DEPARTMENT

STATESVILLE 704-878-5305 MOORESVILLE 704-664-5281

IMPROVEMENT PERMIT / AUTHORIZATION TO CONSTRUCT / OPERATION PERMIT / EXISTING SYSTEM INSPECTION

PERMIT# 225 Mesul. PIN# ~~4645-59-2258~~ 4645-58-4578 DATE Nov. 19, 01

OWNER OR CONTRACTOR Dieust Enterprises Inc. / St. Lawrence Homes PHONE: Business 309-0123 Home

ADDRESS 125 Easton Dr. Mooresville, NC. 28117

LOCATION 21S TL Alcove TR Templeton TR Templeton Bay TL Greenfield 1st on left

SUBDIVISION Templeton Bay BLOCK / SECTION LOT 1 LOT AREA 35,108 sq ft SITE CLASS. PS per 1457 DESIGN FLOW 480 gpd L.T.A.R. .03

Septic Tank: 1000 Gallons: STB Date 9-5-04
Pump Tank: 1000 Gallons: PT Date 8-22-04
Pump Make: Gould's Model WE 0312 Serial No.
Nitrification Field: No Fields 1 Square Feet 540/810 Linear Feet 270
No Lines 4 Trench Width 24" min 30" max Max Trench Bottom Depth 36" Gravel Depth NA

☑ New System ☐ Repair System Type: I, II, III, ☑ V, VI
System Description: LP PPBPS
Repair System Description: SAME
Maintenance Agreement Required: ☑ Yes ☐ No

☑ House/Mod. Home No. Bedrooms 4
☐ Mobile Home No. Bathrooms 4
☐ Business No. Employees
☐ Other

☐ Slab ☑ Crawl Space ☐ Basement w/plumbing ☐ Basement wo/plumbing


Water Supply: ☐ Individual ☑ Public ☑ Community

Comments:/Conditions: Do not cut house site. Backfill only against foundation to provide positive drainage. Remove any old burn in septic system area.

Comments:/Conditions: Checked tanks & lines 10/11/04
62
223 gals max per dose

1"=50'

INITIAL SITE SKETCH

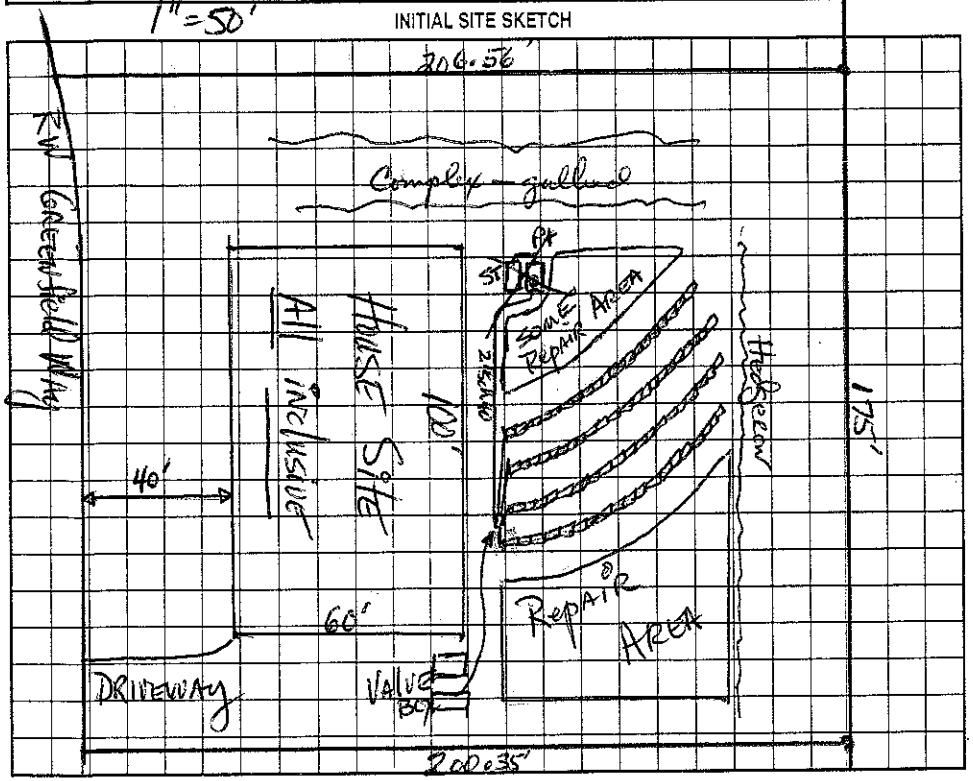

AS BUILT SKETCH

Drainfield installed as Drawn

Permit can be suspended or revoked if any false information is supplied toward securing the permit/any unauthorized changes are made to the site/any unauthorized changes are made in the installation of the system. Improvement Permit with plat valid without expiration. Improvement Permit with site plan valid for sixty months. Authorization to Construct is valid for a period equal to that of Improvement Permit – not to exceed sixty months.

Signed: Robert A. Dieust date 11/16/02

Improvement Permit by: [signature] date 11-19-01

Authorization to Construct by: Maria H. Dolson RS date 7/13/04

Installed by: R.S. date

Operation Permit by: Maria H. Dolson date 10/14/04

Existing System Inspection by: date

HEALTH DEPT. COPY: WHITE OWNER COPY (FINAL): YELLOW OWNER COPY (INITIAL): PINK