1-7808 Paid 125.00 1130-2106

# IREDELL COUNTY HEALTH DEPARTMENT

STATESVILLE 704-878-5305 MOORESVILLE 704-664-5281

## IMPROVEMENT PERMIT / AUTHORIZATION TO CONSTRUCT / OPERATION PERMIT / EXISTING SYSTEM INSPECTION

PERMIT# 225 & MRSW1. PIN# ~~4645-54-2250~~ 4645590730.008 DATE Dec 18,01

OWNER OR CONTRACTOR ~~Dicus Enterprises Inc~~ ST LAWRENCE HOMES PHONE: Business _____ Home _____

ADDRESS 125 EASTON DR. MOORESVILLE NC 28117

LOCATION 215 TL ALCOVE TR TEMPLETON TR TEMPLETON BAY DR. on left past jct w/ PAULS LANE

SUBDIVISION TEMPLETON BAY BLOCK / SECTION _____ LOT 34/34A LOT AREA 20759 + 14400 ft² SITE CLASS. PS SFE DESIGN FLOW 480 gpd L.T.A.R.# 025 SFE 34A

Septic Tank: 1000 Gallons; STB 312 Date 1-3-04
Pump Tank: 1000 Gallons; PT 283 Date 3-22-04
Pump Make: Meyers Model P102 Serial No. _____
Nitrification Field: No Fields 1 Square Feet 1500 Linear Feet 500
No Lines 5@100' Trench Width 36" Max Trench Bottom Depth 36"

☑ New System ☐ Repair System Type: I, II, ⓘ IV, V, VI
System Description: pm INNOVATIVE 25% Reduction SFE 34A
Repair System Description: LPPPBPS
Maintenance Agreement Required: ☐ Yes ☑ No initially

Gravel Depth NA


☑ House/Mod. Home ☐ Mobile Home ☐ Business ☐ Other
No. Bedrooms 4 No. Bathrooms 4 No. Employees _____
☐ Slab ☐ Crawl Space ☑ Basement w/plumbing ☐ Basement wo/plumbing

Water Supply: ☐ Individual ☑ Public ☑ Community

Comments/Conditions:
Remove any old burnus IN Septic field EASEMENT.

Comments/Conditions: Checked tanks & lines 4/29/04
Installed EZ Flow Drainfield
Checked pressure, elect. & Alarm

INITIAL SITE SKETCH

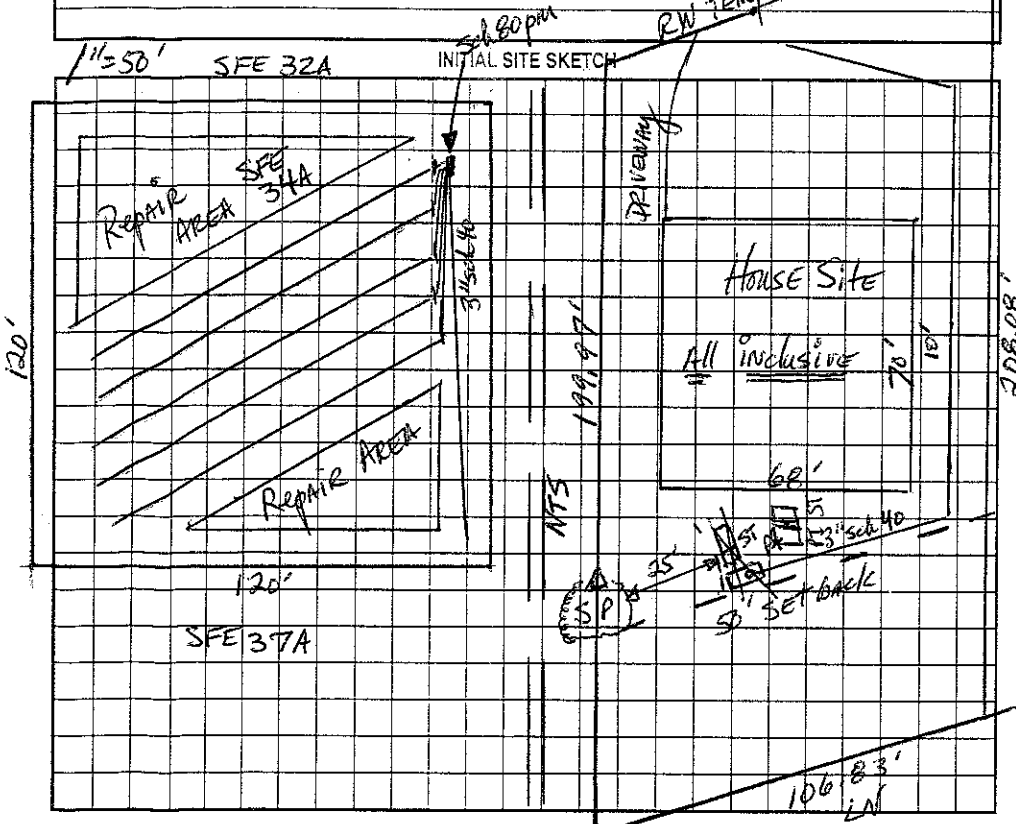


AS BUILT SKETCH

Permit can be suspended or revoked if any false information is supplied toward securing the permit/any unauthorized changes are made to the site/any unauthorized changes are made in the installation of the system. Improvement Permit with plat valid without expiration. Improvement Permit with site plan valid for sixty months. Authorization to Construct is valid for a period equal to that of Improvement Permit – not to exceed sixty months.

Signed: Robert B. Dicus date 1/29/02
Improvement Permit by: Mark Johnson, RS date 12-18-01
Authorization to Construct by: Wendy Sparks RS. date 1/13/04

Installed by: R & H Inc
Operation Permit by: Mark Johnson RS date 5/4/04
Existing System Inspection by: _____ date _____

HEALTH DEPT. COPY: WHITE OWNER COPY (FINAL): YELLOW OWNER COPY (INITIAL): PINK