122896

IREDELL COUNTY HEALTH DEPARTMENT

STATESVILLE 704-878-5305 MOORESVILLE 704-664-5281

IMPROVEMENT PERMIT / AUTHORIZATION TO CONSTRUCT / OPERATION PERMIT / EXISTING SYSTEM INSPECTION

400

PERMIT# 225 Mpsil. PIN# 4645-59-2252 4645-59-1273 DATE Dec 11,0

OWNER OR CONTRACTOR Dienst Enterprises Inc. / St. Lawrence Homes TELEPHONE Business Home

ADDRESS 125 Epsom Dr. Mooresville, NC 28117

LOCATION 215 TL Alcove TR Templeton TR Templeton Bay TR Templeton Bay TR Katie Spencer on Right

SUBDIVISION Templeton Bay BLOCK / SECTION LOT 29 LOT AREA 34,429 Ft² SITE CLASS PS from 1956 DESIGN FLOW 460 gpd L.T.A.R. .125

Septic Tank: 1000 Gallons; STB 312 Date 11-26-04

Pump Tank: 1000 Gallons; PT 27 Date 11-16-04

Pump Make: Myers Model ME50S-21 Serial No.

Nitrification Field: No Fields 1 Square Feet 640/960 Linear Feet 320

No Lines 4 @ 80' Trench Width 24" min 36" Max Trench Bottom Depth 36" Gravel Depth NA

☑ New System ☐ Repair System Type: I, II, III, IV, V, VI

System Description: LPPBFS

Repair System Description: Same

Maintenance Agreement Required: ☑ Yes ☐ No

☑ House/Mod. Home No. Bedrooms 4

☐ Mobile Home No. Bathrooms 4

☐ Business No. Employees

☐ Other

☐ Slab ☐ Crawl Space ☑ Basement w/plumbing ☐ Basement wo/plumbing


Water Supply: ☐ Individual ☑ Public ☑ Community

Comments:/Conditions:
Remove old burns & hedgerow.


Comments:/Conditions: Checked tanks & lines 12/21/04 MD
Contract attached

1"=50'

INITIAL SITE SKETCH

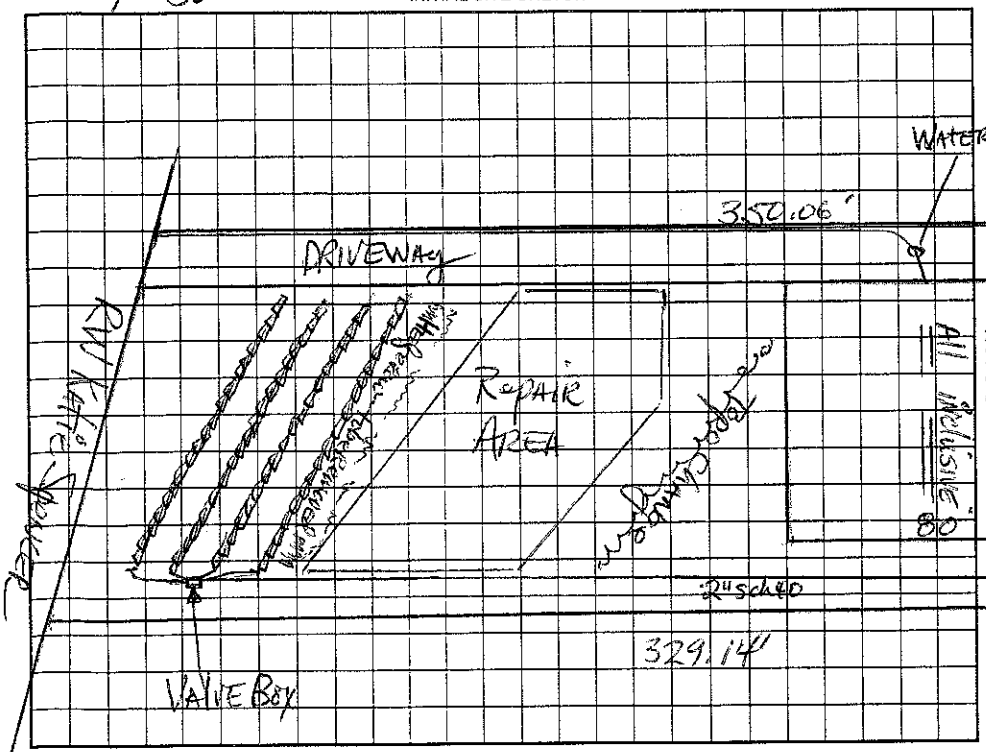

AS BUILT SKETCH

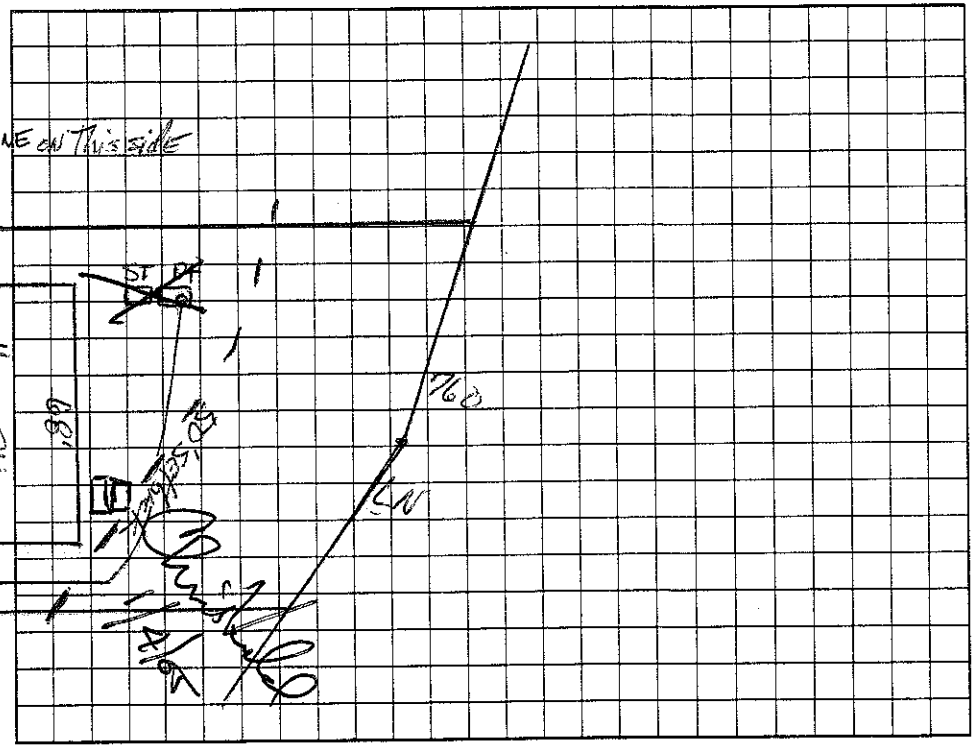

Permit can be suspended or revoked if any false information is supplied toward securing the permit/any unauthorized changes are made to the site/any unauthorized changes are made in the installation of the system. Improvement Permit with plat valid without expiration. Improvement Permit with site plan valid for sixty months. Authorization to Construct is valid for a period equal to that of Improvement Permit – not to exceed sixty months.

Signed: Robert B. Dienst date 1/16/02

Improvement Permit by: date 12-1-04

Authorization to Construct by: date 1/9/04

Installed by: R & H

Operation Permit by: date 1/5/05

Existing System Inspection by: date

HEALTH DEPT. COPY: WHITE OWNER COPY (FINAL): YELLOW OWNER COPY (INITIAL): PINK