121 752 10"

IREDELL COUNTY HEALTH DEPARTMENT

STATESVILLE 704-878-5305 / 125.00 Paid MOORESVILLE 704-664-5281 213

IMPROVEMENT PERMIT / AUTHORIZATION TO CONSTRUCT / OPERATION PERMIT / EXISTING SYSTEM INSPECTION

PERMIT# 225 MRSVL PIN# 4645-59-~~4450~~ Homes 4645591595

OWNER OR CONTRACTOR Dienst Enterprises Inc. / ST Lawrence PHONE: Business _____ Home _____ DATE Dec 17, 01

ADDRESS 125 Easton Dr. Mooresville NC 28117

LOCATION 215 TL Alcove TR Templeton TR Templeton Bay on left across from Paula Lane

SUBDIVISION Templeton Bay BLOCK / SECTION _____ LOT 32/32A LOT AREA 21,001 + 14,400 ft² SITE CLASS. RS DESIGN FLOW 480 gpd L.T.A.R. .03 SFE 32A

Septic Tank: 1000 Gallons; STB 312 Date 9-28-04 ☑ New System ☐ Repair System Type: I, II, III, IV, V, VI

Pump Tank: 1000 Gallons; PT 27 Date 10-4-04 System Description: PM-Innovative-25% Red on 32A

Pump Make: Myers Model MFS2-20 Serial No. _____ Repair System Description: LPPBPS

Nitrification Field: No fields 1 Square Feet 1200 Linear Feet 400 Maintenance Agreement Required: ☐ Yes ☑ No

No Lines 4@100' Trench Width 36" Max Trench Bottom Depth 36" Gravel Depth NA

☑ House/Mod. Home No. Bedrooms 4 ☐ Mobile Home No. Bathrooms 4 ☐ Business No. Employees _____ ☐ Other _____

☐ Slab ☐ Crawl Space ☑ Basement w/plumbing ☐ Basement wo/plumbing

Water Supply: ☐ Individual ☐ Public ☐ Community


Comments:/Conditions:

Remove any old barns in septic system area

Comments:/Conditions: Checked tanks & lines 11/16/04

Check elect, pressure & alarm 11/19/04

INITIAL SITE SKETCH

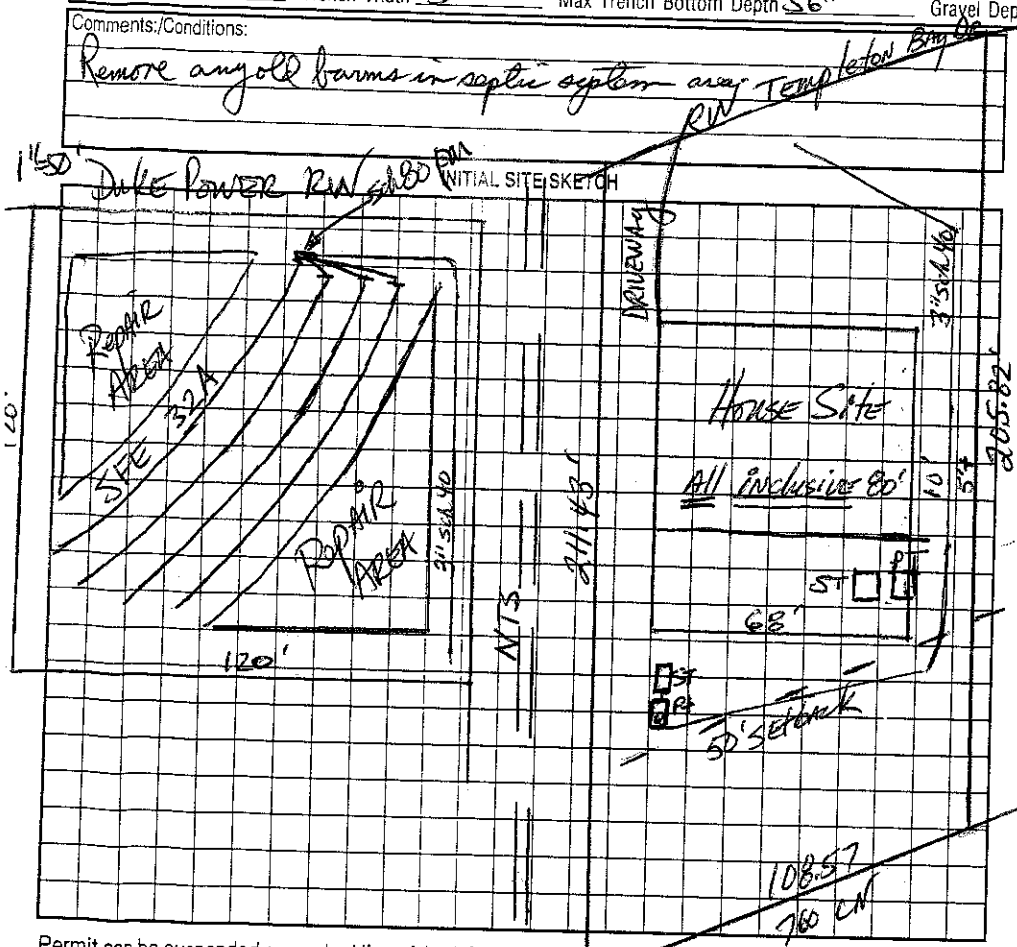

AS BUILT SKETCH

Installed EZ flow, essentially as Drawn.

Permit can be suspended or revoked if any false information is supplied toward securing the permit/any unauthorized changes are made to the site/any unauthorized changes are made in the installation of the system. Improvement Permit with plat valid without expiration. Improvement Permit with site plan valid for sixty months. Authorization to Construct is valid for a period equal to that of Improvement Permit = not to exceed sixty months.

Signed: Robert B. Dienst date 11/29/02

Improvement Permit by: Mark Thomas RS date 12-17-01

Authorization to Construct by: _____ RS date 6/16/04

Installed by: R & H Inc. RS

Operation Permit by: Marvin Dotson date 11/19/04

Existing System Inspection by: _____ date _____

HEALTH DEPT. COPY: WHITE OWNER COPY (FINAL): YELLOW OWNER COPY (INITIAL): PINK