112527

IREDELL COUNTY HEALTH DEPARTMENT

STATESVILLE 704-878-5305 125.00 Paid MOORESVILLE 704-664-5281

IMPROVEMENT PERMIT / AUTHORIZATION TO CONSTRUCT / OPERATION PERMIT / EXISTING SYSTEM INSPECTION

PERMIT# 225 112527 Built PIN# 4645-59-2250 4645-59-1622 DATE Dec 18, 01

OWNER OR CONTRACTOR Dienst Enterprises Inc. / St. Lawrence Homes PHONE: Business 704 892-7706 Home

ADDRESS 125 Easton Dr. Mooresville NC 28117

LOCATION 215 TL Alcove TR Templeton TR Templeton Bay DR. on left just past jct w/ Pauls Lane

SUBDIVISION Templeton Bay BLOCK / SECTION LOT 33/33A LOT AREA 21,113 + 14,400 ft² SITE CLASS. PS SFE DESIGN FLOW 460 gpd L.T.A.R. .3 SFE 33A

Septic Tank: 1000 Gallons; STB 794 Date 1-20-03
Pump Tank: 1000 Gallons; PT 27 Date 5-12-03
Pump Make: Model Serial No.
Nitrification Field: No Fields 1 Square Feet 1200 Linear Feet 400
No Lines 4@100' Trench Width 36" Max Trench Bottom Depth 36" Gravel Depth NA

☑ New System ☐ Repair System Type: I. II. III IV. V. VI
System Description: PM- Innovative -25% Red.
Repair System Description: Same
Maintenance Agreement Required: ☐ Yes ☑ No


☑ House/Mod. Home No. Bedrooms 4
☐ Mobile Home No. Bathrooms 4
☐ Business No. Employees
☐ Other

☐ Slab ☐ Crawl Space ☑ Basement w/plumbing ☐ Basement wo/plumbing

Water Supply: ☐ Individual ☑ Public ☐ Community


Comments:/Conditions:
Remove any old burins in Septicfield easement

INITIAL SITE SKETCH

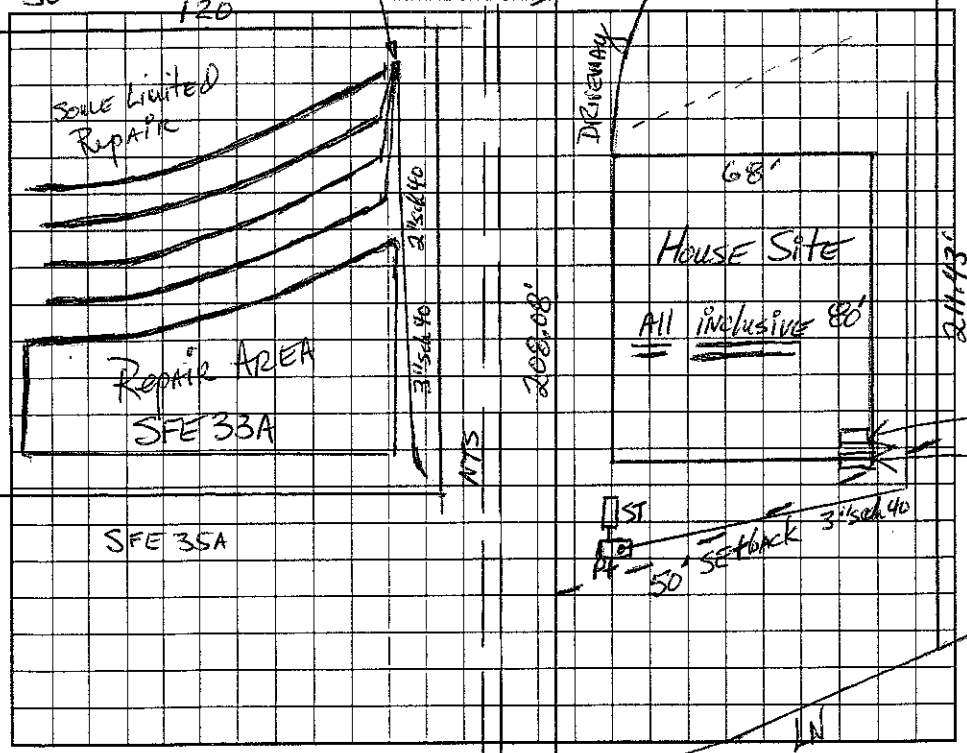

Comments:/Conditions: Tanks checked 8/19/03
Lines checked 10/14/03
Pressure, Electrical & Alarm 10/20/03

AS BUILT SKETCH

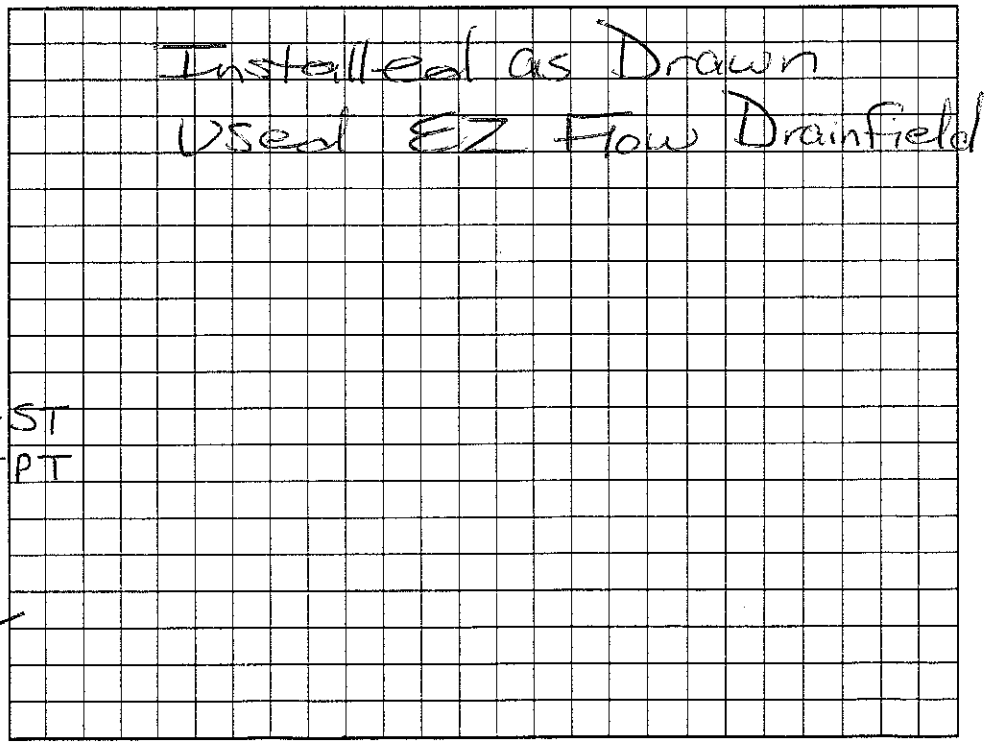

Permit can be suspended or revoked if any false information is supplied toward securing the permit/any unauthorized changes are made to the site/any unauthorized changes are made in the installation of the system. Improvement Permit with plat valid without expiration. Improvement Permit with site plan valid for sixty months. Authorization to Construct is valid for a period equal to that of Improvement Permit – not to exceed sixty months.

Signed: Robert B. Dienst date 1/29/02

Improvement Permit by: Mark Johnson RS date 12-18-01

Authorization to Construct by: RS date 4/25/03

Installed by: R&H

Operation Permit by: Mark H. Dotson RS date 10/20/03

Existing System Inspection by: date

HEALTH DEPT. COPY: WHITE OWNER COPY (FINAL): YELLOW OWNER COPY (INITIAL): PINK